


T. 37 S., R. 6 W., W.M.

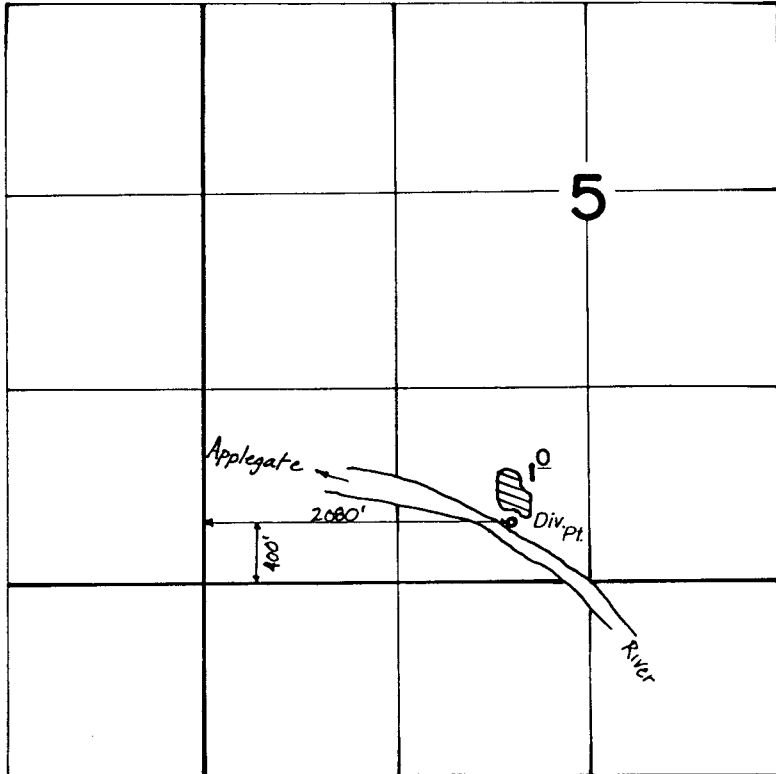

RECEIVED

APR 15 1987

WM. DIST. 14  
GRANTS PASS, OR.

**FINAL PROOF SURVEY**  
UNDER

Application No. 62194 46073  
59539 Permit No. 44920  
IN NAME OF

**WILLIAM H. PINALTO**

Surveyed AUG. 10. 1982, by B. S. JAMES

B50-3-11 mc 2/84