


T. 37 S., R. 6 W., W.M.

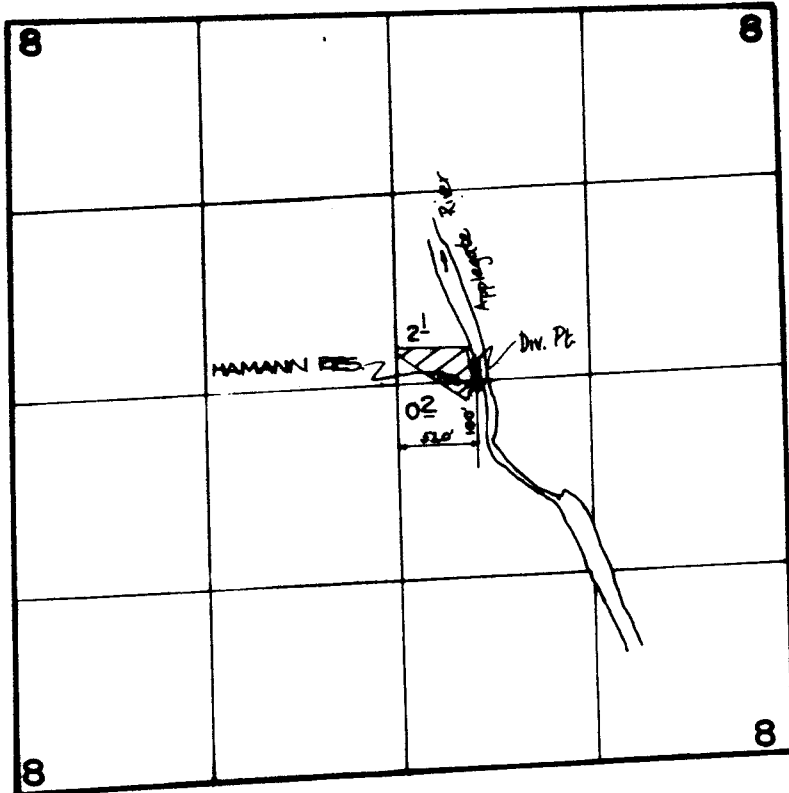

RECEIVED

AUG 23 1989

REG. DIST. TO
GEOLOGICAL SURVEY, OREG.

FINAL PROOF SURVEY UNDER

Application No. **62198** Permit No. **46076**
60234 **45130**
IN NAME OF

DALE B. & EURETHA M. HAMANN

Surveyed **OCT. 17, 1983**, by **B. S. JAMES**

B50-2-9 me