


T. 37S., R. 6W., W.M.

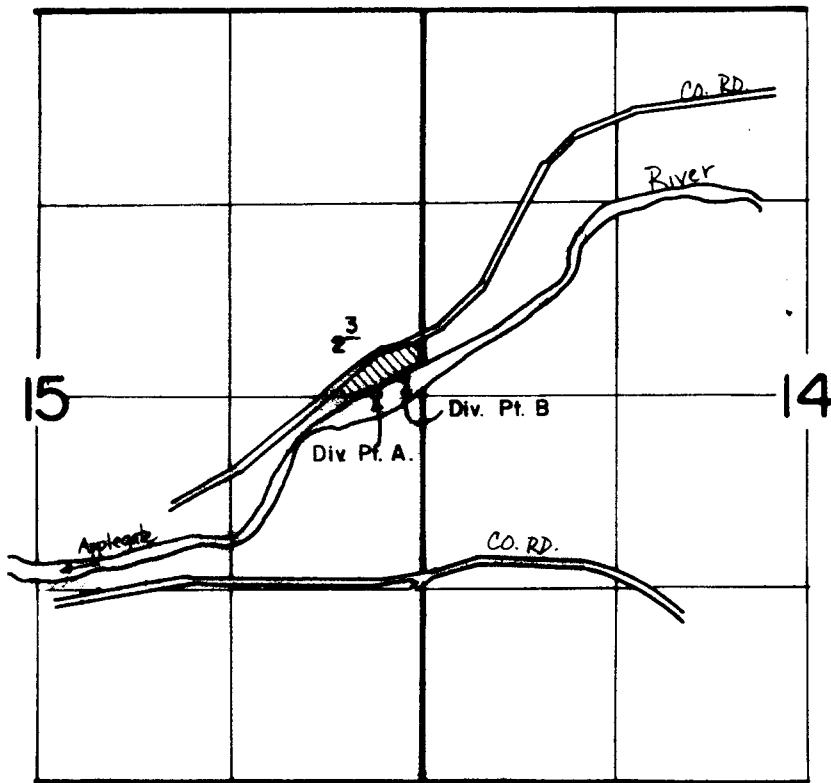

SEP 1989

Div. Pt. A located 10' N. & 320' W.; Div. Pt. B located 100' N. & 100' W. both from the East 1/4 Corner, Sec. 15.

FINAL PROOF SURVEY
UNDER

Application No. 62199.... Permit No. 46077.....
IN NAME OF

.....**LAWRENCE C. HUCK**.....

Surveyed Q.C.T. 19, 1983., by B.S. JAMES.....

B50-2-6 me