


T.37S., R.6 W., W.M.

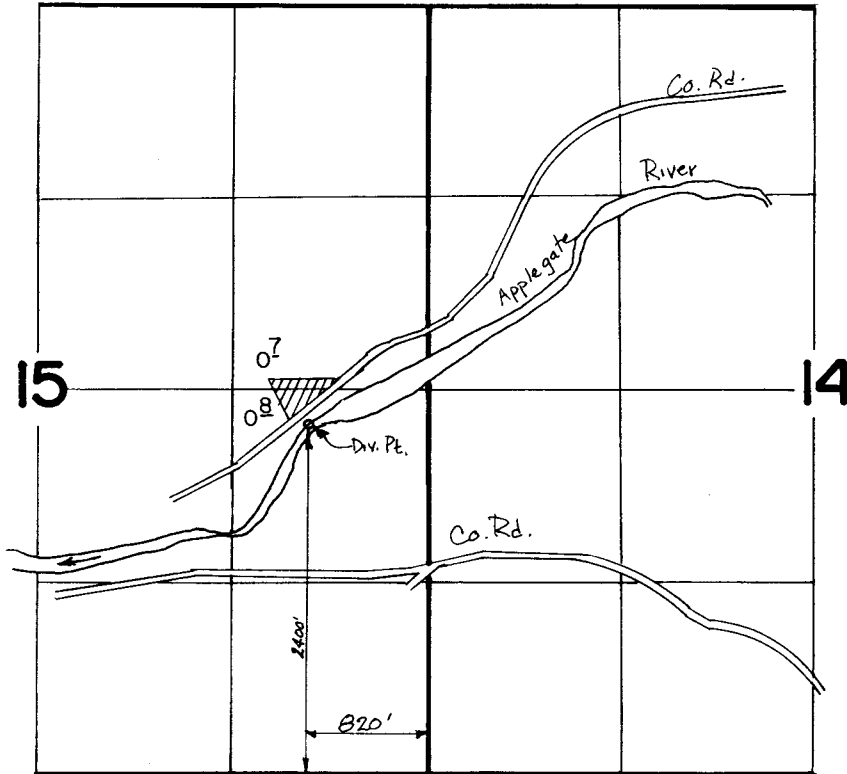

RECEIVED

JUL 25 1991

WM DIST. 14
GRANTS PASS, ORE.

FINAL PROOF SURVEY
UNDER

Application No. 62200.. Permit No. 46078.....
IN NAME OF

DAN MCLOUD

Surveyed OCT. 19, 1983., by B.S. JAMES.....

RECEIVED

JUL 9 1991

WATER MASTER
DISTRICT 13