


T. 37 S., R. 6 W., W.M.

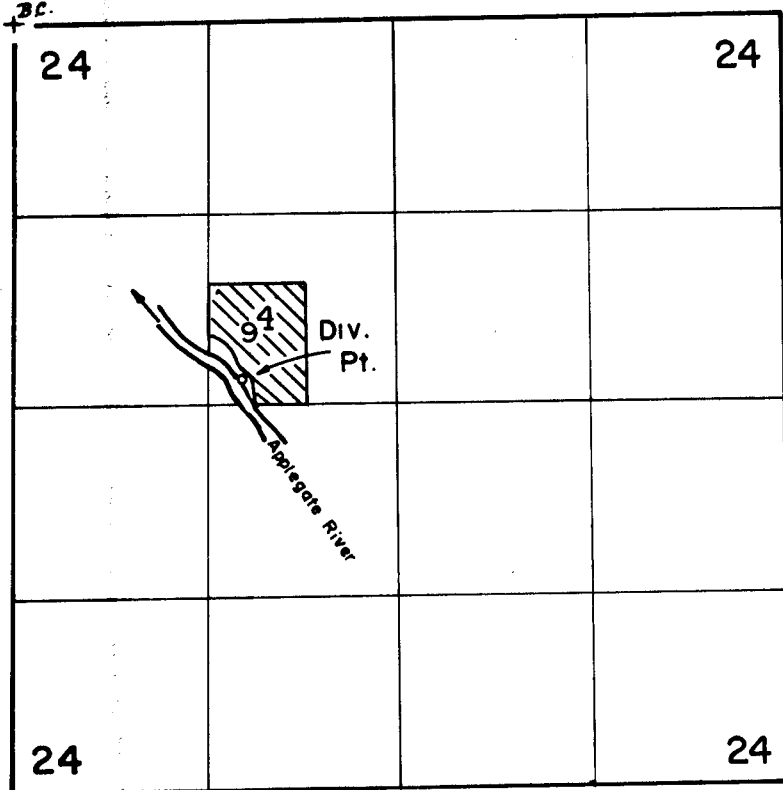

SCALE:  
1" = 1320'

Div. Pt. - 170' N., 1050' W.,  
from C. cor., Sec. 24

RECEIVED  
SEP 4 1990  
WM. DIST. 14  
GRANTS PASS, ORE.

**FINAL PROOF SURVEY**  
UNDER

**TRANSFER NO. 4849**

Application No. **62351** Permit No. **46089**  
IN NAME OF

**HARRY LA. CHANCE, JR.**

Surveyed **JUL. 29. 1986**, by **B. S. JAMES**