

46128

RECEIVED

38-6-23

JUN 3 1981


WATER RESOURCES DEPT
SALEM, OREGON

UNITED STATES
DEPARTMENT OF THE INTERIOR
BUREAU OF LAND MANAGEMENT

Oregon State Water Filings

TOWNSHIP 38S., RANGE 6W., W. M.

SECTION
23
SE 1/4 SW 1/4

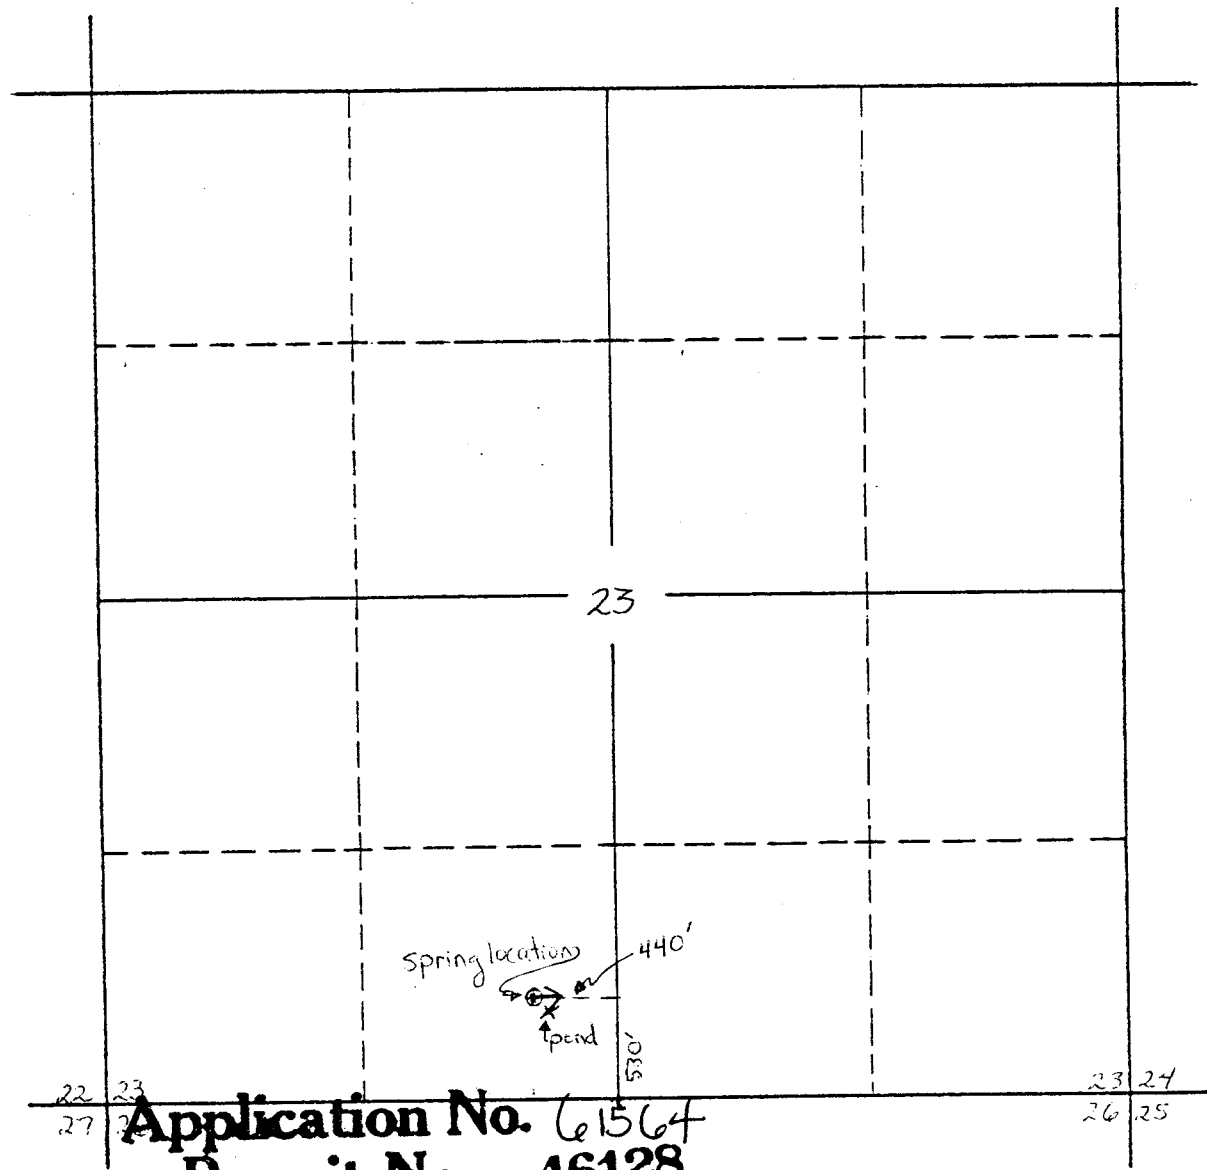

Application No. 61564
Permit No. 46128

SCALE : 1" = 1000'

RECEIVED

APR 21 1981

WATER RESOURCES DEPT
SALEM, OREGON