


T. 38 S., R. 5 W., W. M.

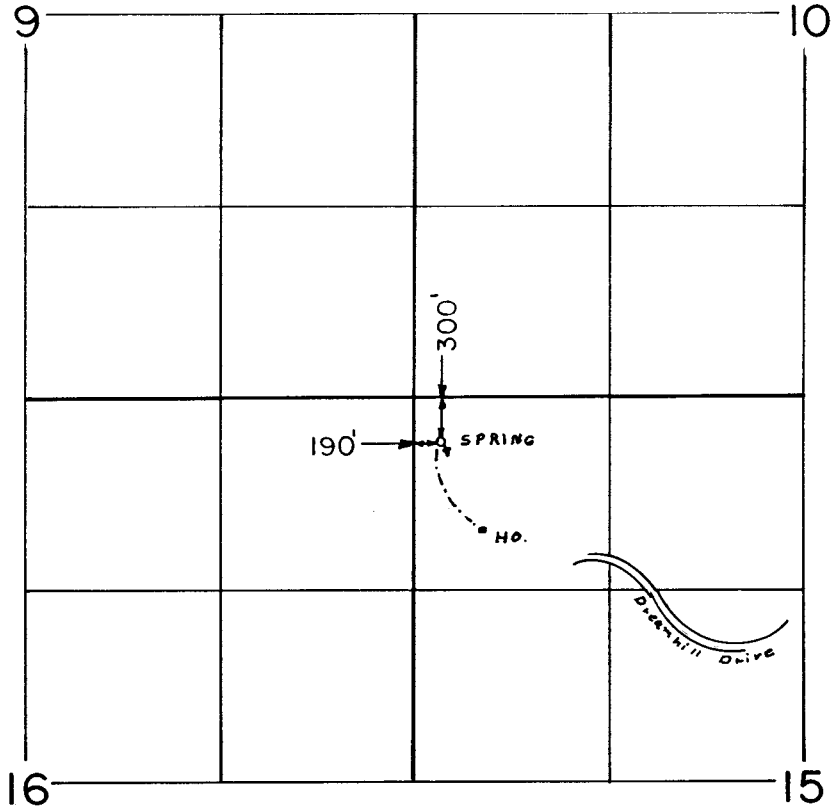

76123

Scale: 1" = 1320'

FINAL PROOF SURVEY UNDER

Application No. 61691.. Permit No. 46130....
IN NAME OF

.....EARL.....HVALL.....

Surveyed MAY.13... 1991.., by L.M...JOACHIMS.