




T. 34 S., R. 5 W., W.M.

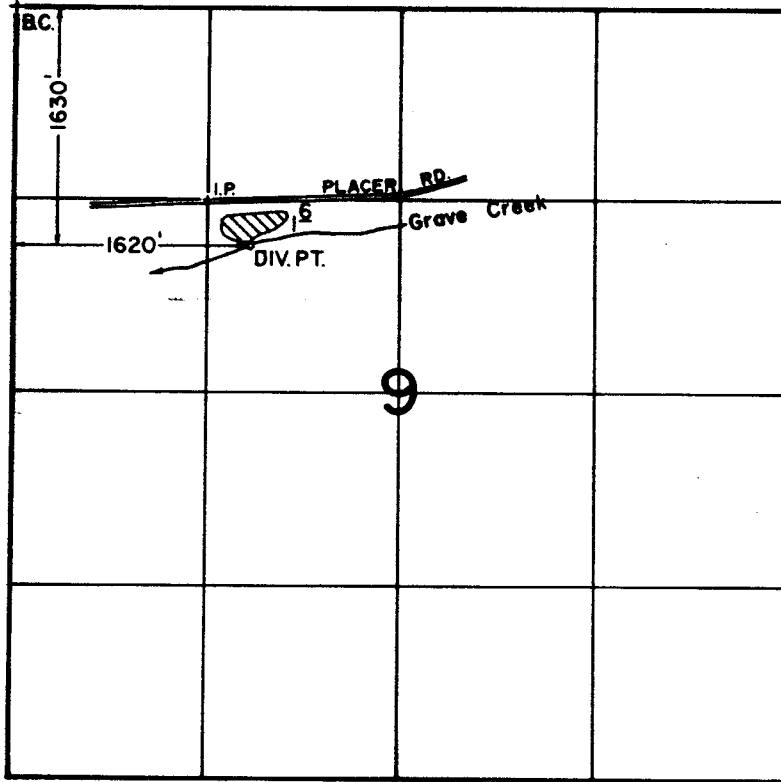

SCALE: 1" = 1320'

FINAL PROOF SURVEY
UNDER

Application No. 60963.. Permit No. 46202.....
IN NAME OF

.....**LOUIS E. HAAG**.....

Surveyed **MAY 11**..... 1989, by **B. C. JAMES**.....

9-1-89
41033-179-120L

1989