
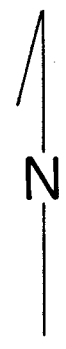


41-9-14

# T. 41 S., R. 9 W., W. M.

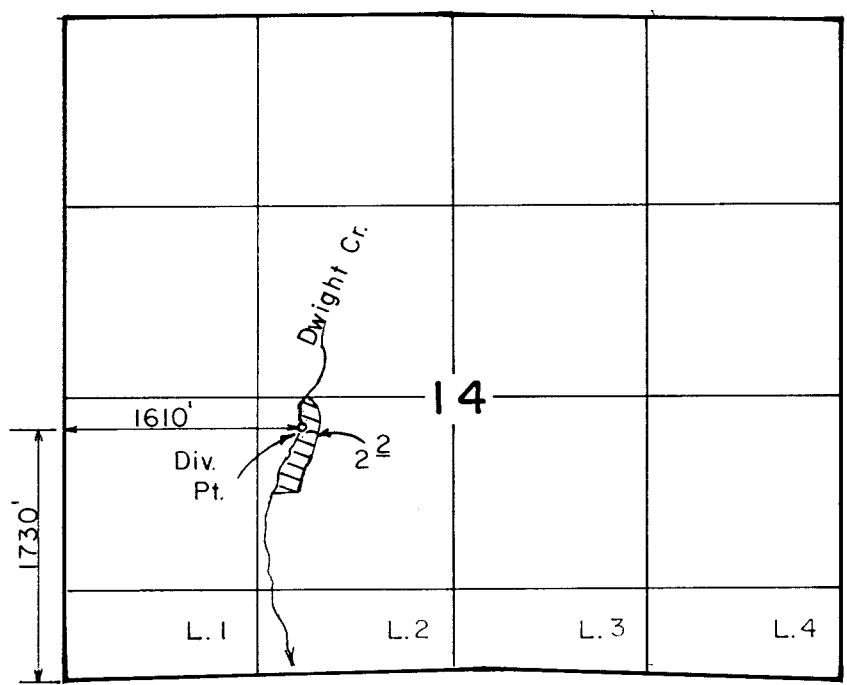

CALIFORNIA

Scale: 1" = 1320'

DEC

WM. OF. 12 -  
GRANTS PASS, ORIG

## FINAL PROOF SURVEY UNDER

Application No. 61880.. Permit No. 46255...  
IN NAME OF

RONALD... W. & CYNTHIA... L. HANCOCK

Surveyed APR. 11, 1988, by B. S. JAMES...

41233-119-2721