


T. 36 S., &
 T. 37 S., R. 6 W., W. M.

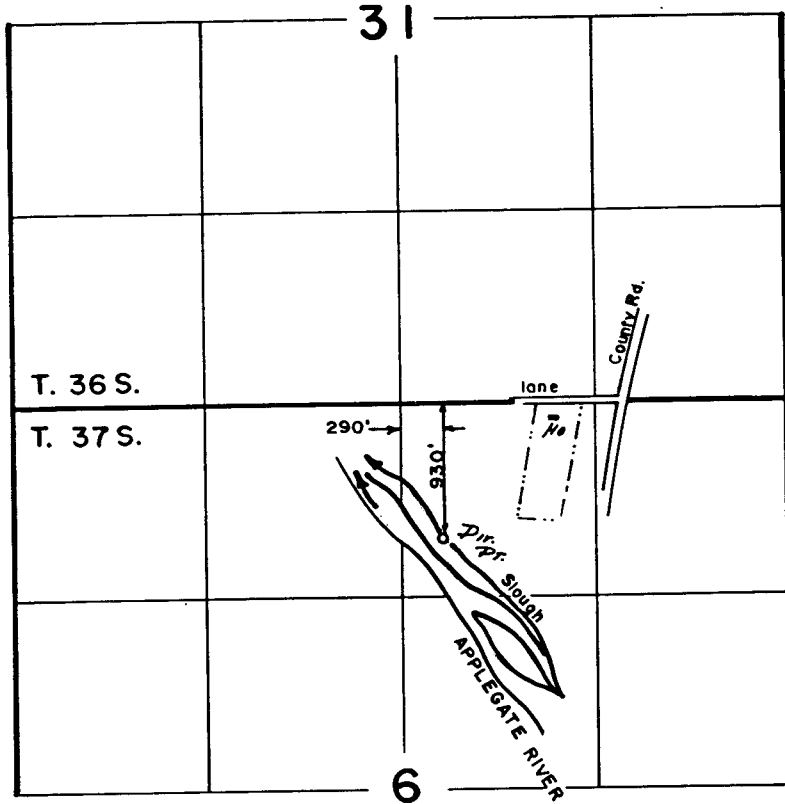

SCALE:
 1" = 1320'

RECEIVED
 SEP 1 1987

W.M. DIST. 14
 GRANTS PASS, ORE.

FINAL PROOF SURVEY
 UNDER

TRANSFER NO. 4811
 Application No. 61860 Permit No. 46262
 IN NAME OF

Richard D. and Veda I. Connor.....

Surveyed JUL. 30. 1986., by B. S. JAMES.....

B50-3-11 2A3