


Application No. 61915
Permit No. 46269

RECEIVED
JUL 17 1981
WATER RESOURCES DEPT
SALEM, OREGON

Edward Spicer D.L.C. No 39
for

Ted. Hansen 2832 Ridgeway Drive, Rockport
scale: 1" = 100' Nov. 12, 1968

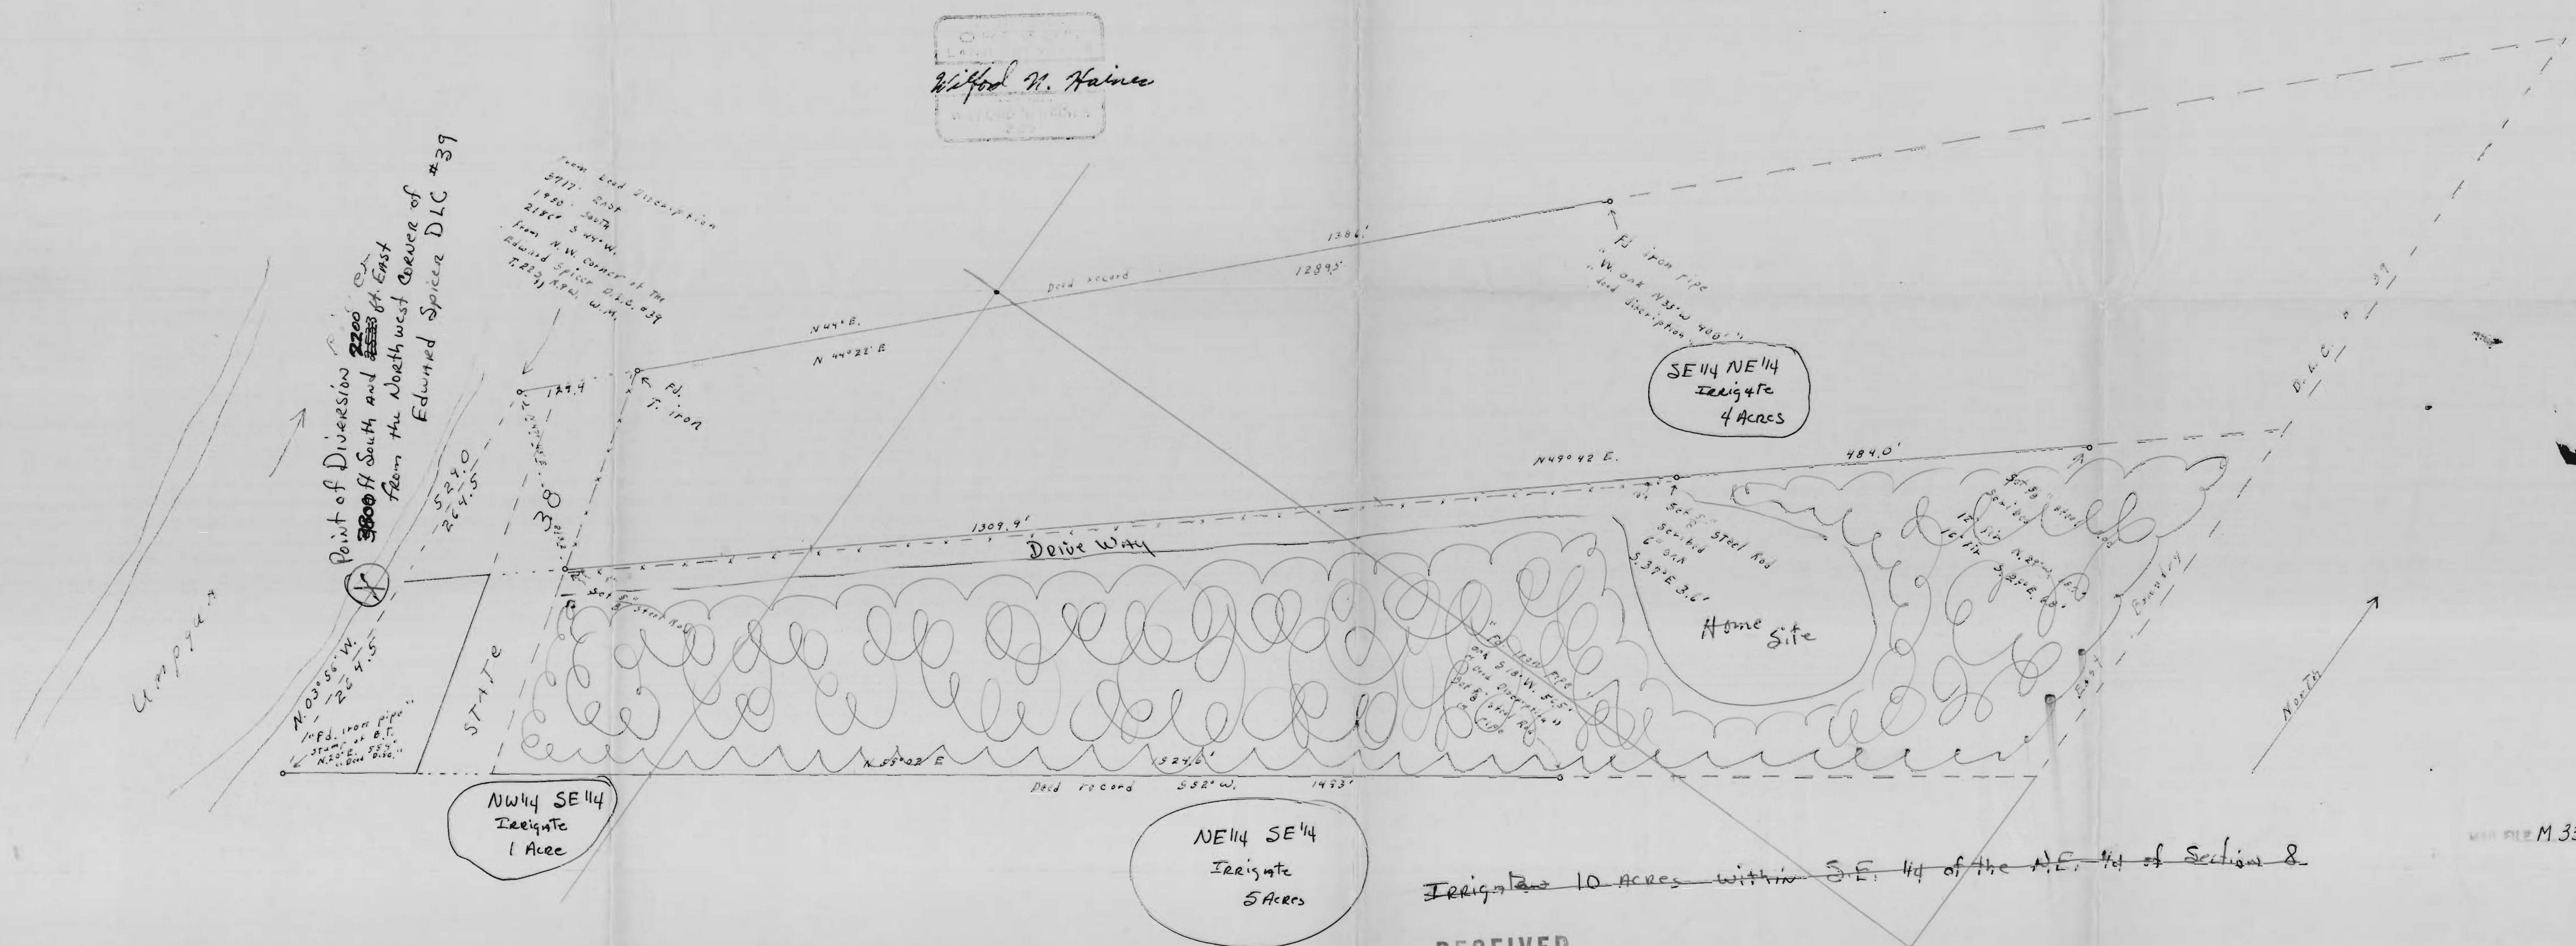

RECEIVED

JAN 12 1982

M 33 - 45