


SECTION 22 T39S R3W WN

SCALE 1"=400'

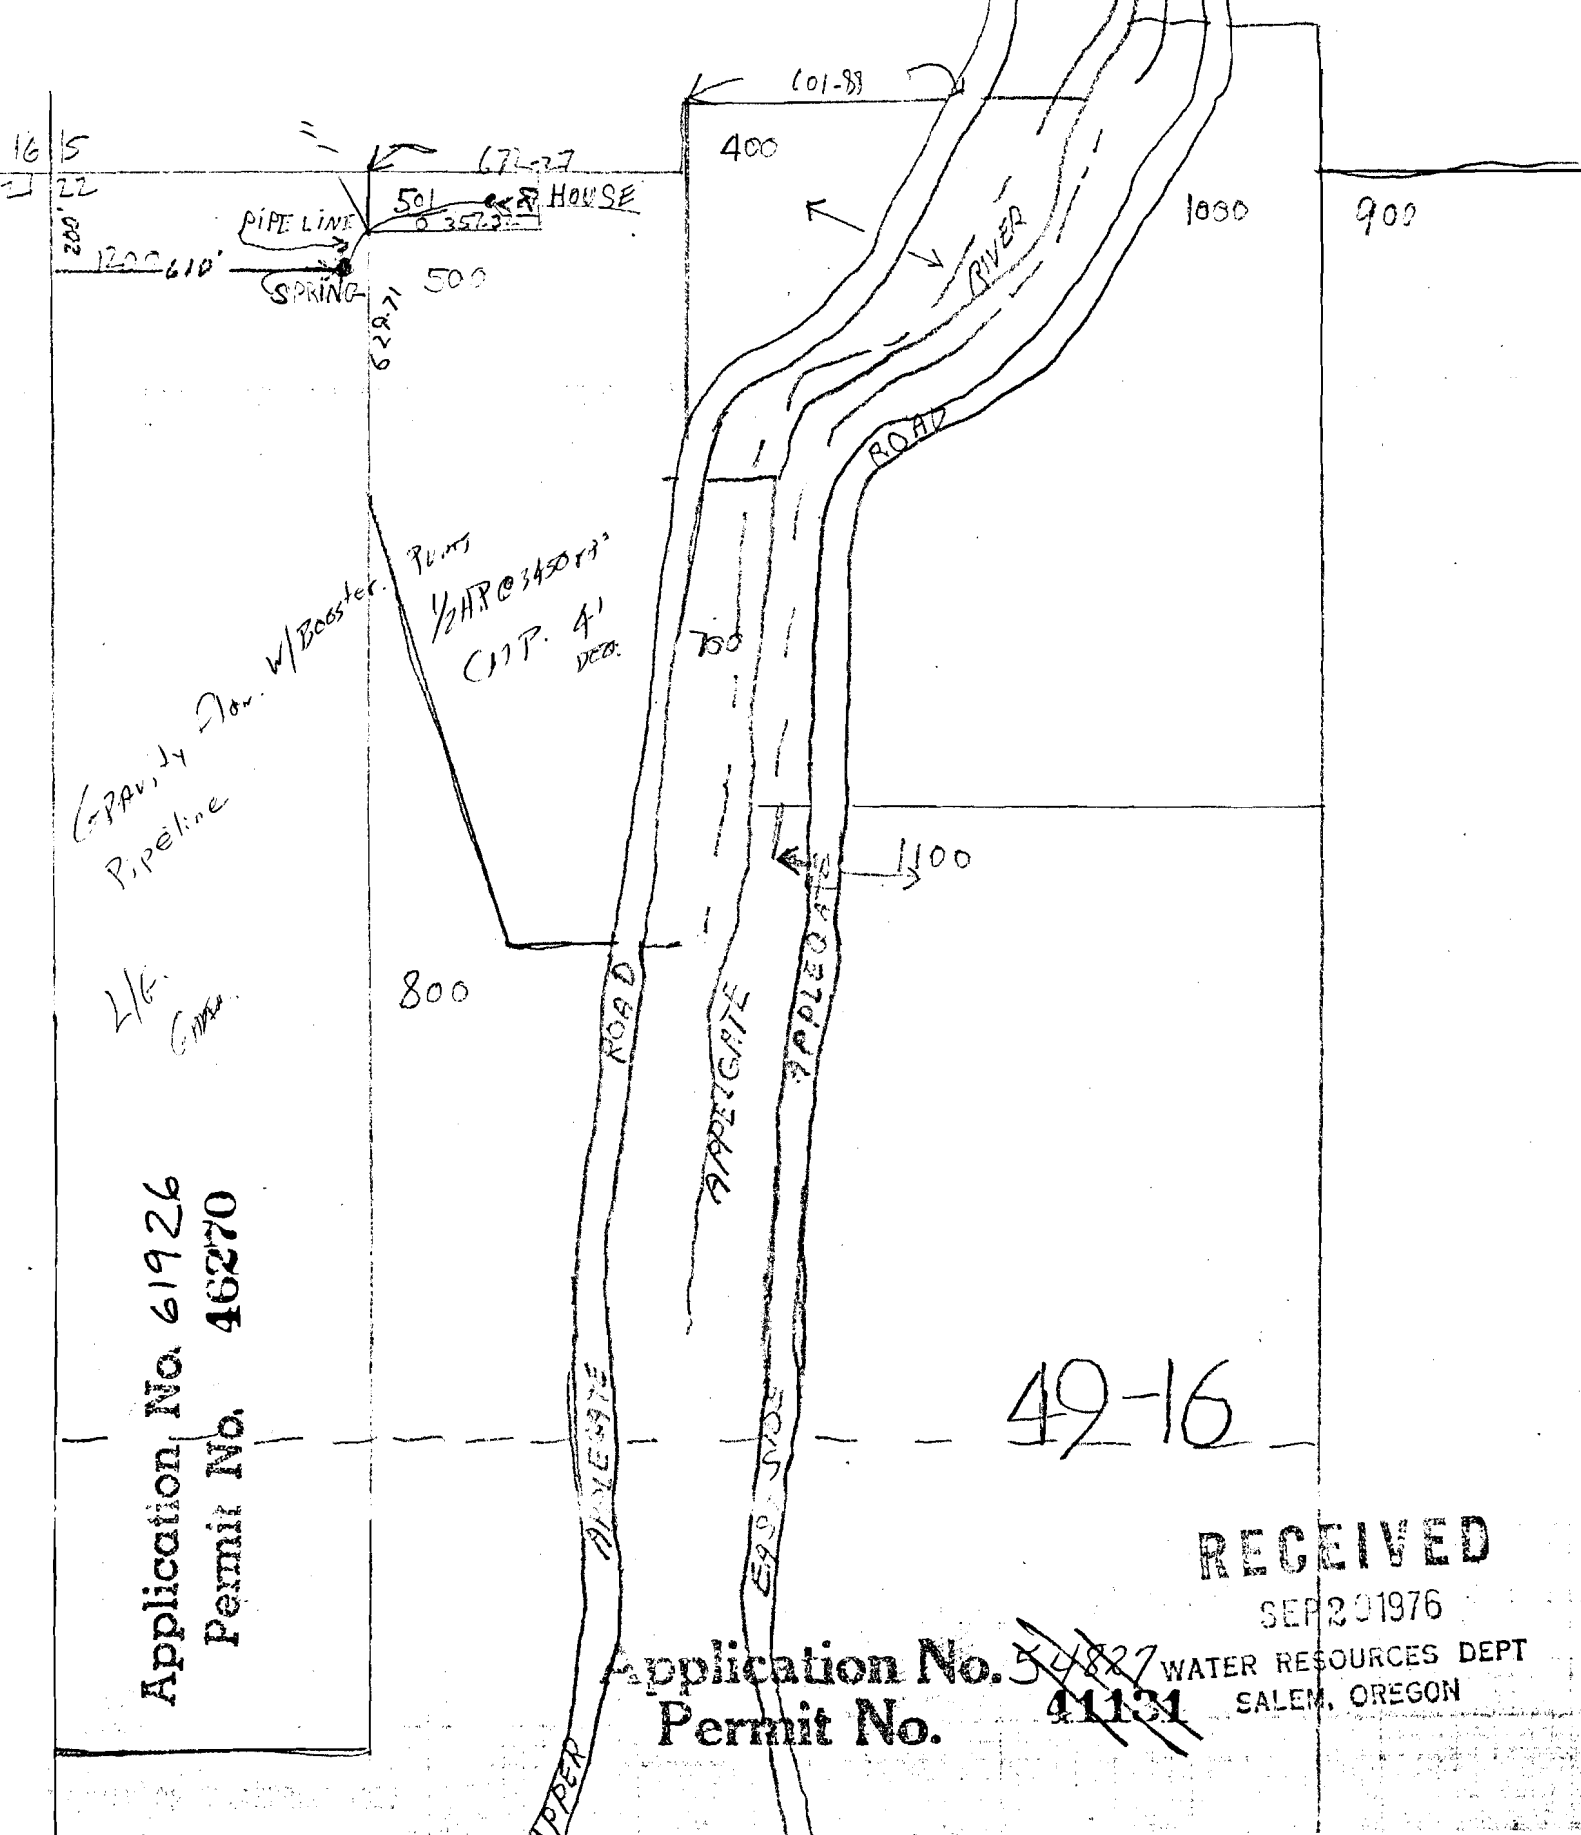

Application No. 61926  
 Permit No. 46270

49-16

RECEIVED

SEP 29 1976

Application No. ~~54827~~ WATER RESOURCES DEPT  
 Permit No. 41131 SALEM, OREGON