

Edward J. Cooley

NW 1/4 of NE 1/4 of Sec 13, T.23S, R8W,
W.M., Douglas Co. Ore.

1/4 Corner between
Sec 12 & Sec 13


Application No. 60486

Permit No. 46290

RECEIVED

DEC 11 1981

WATER RESOURCES
SALEM, OREGON

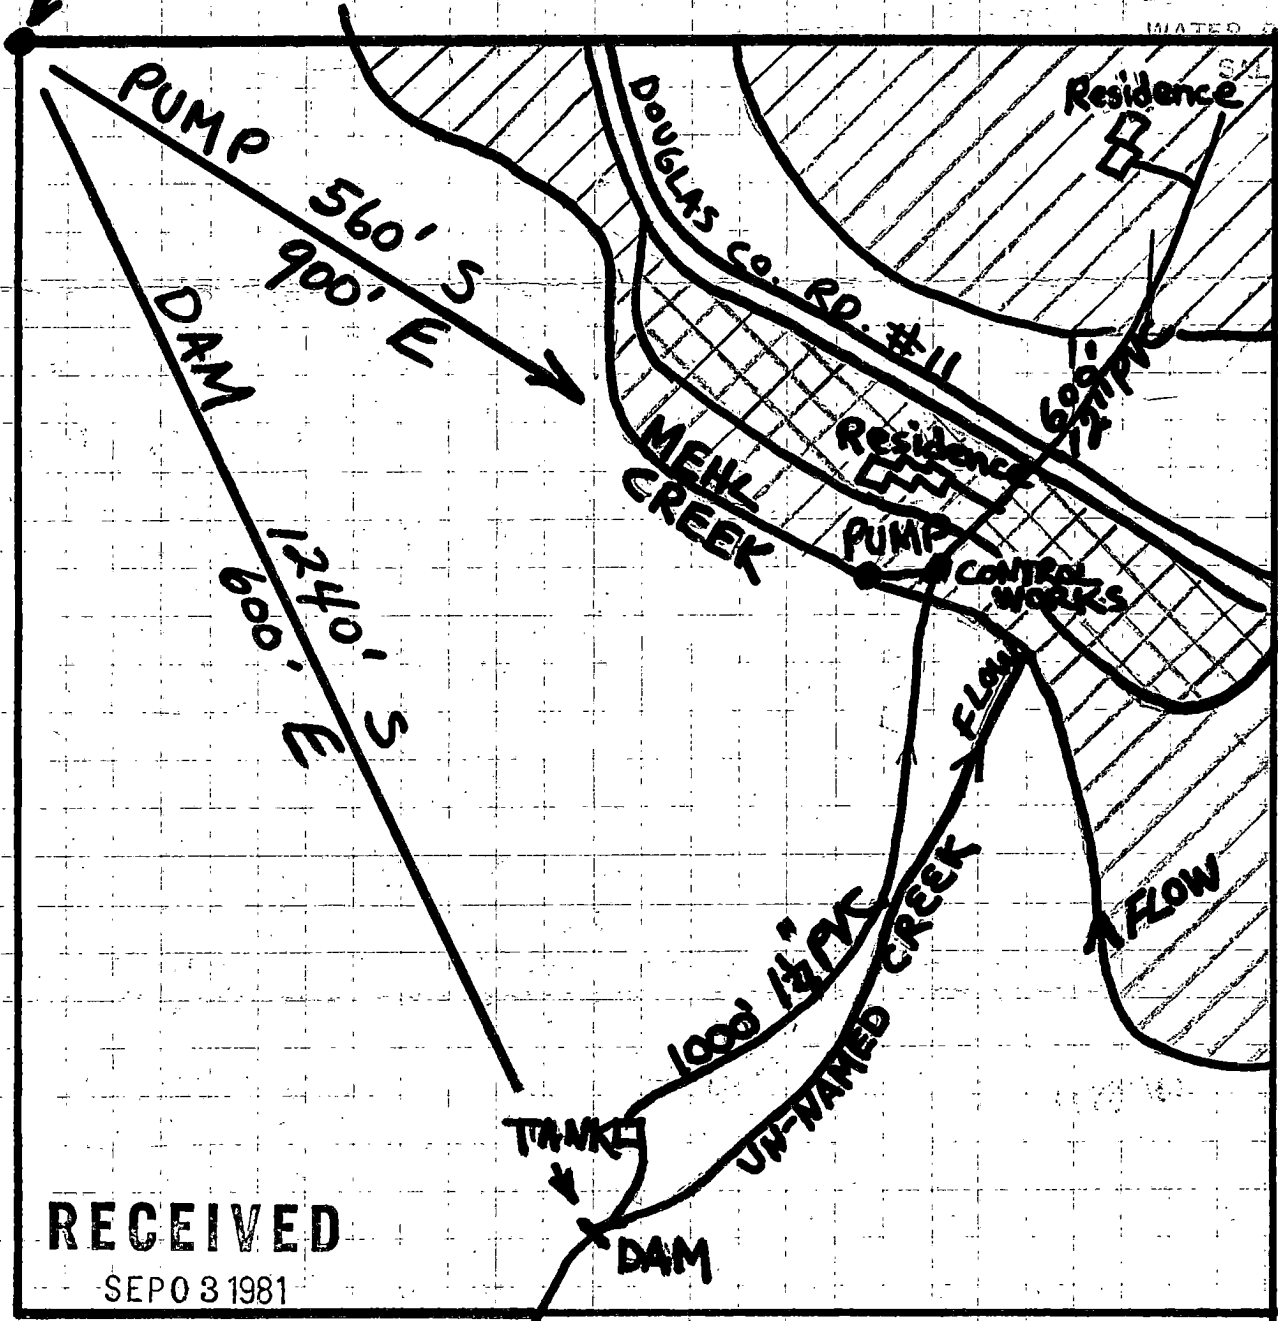

RECEIVED

SEP 03 1981

WATER RESOURCES DEPT
SALEM, OREGON

10A Total



(1.4 Ac) ^{CERTIFICATE} EXISTING PERMIT # 46155
 (8.6 Ac) ADDITIONAL IRRIGATION
 1"=200'