

RECEIVED


MAR 8 1982

WATER RESOURCES DEPT
SALEM, OREGON



Scale 0" = 1 mile
or 1" = 660'

Lake Shore Development DBA Blue Lake Resort
Sec 27 T135 R8E W4M

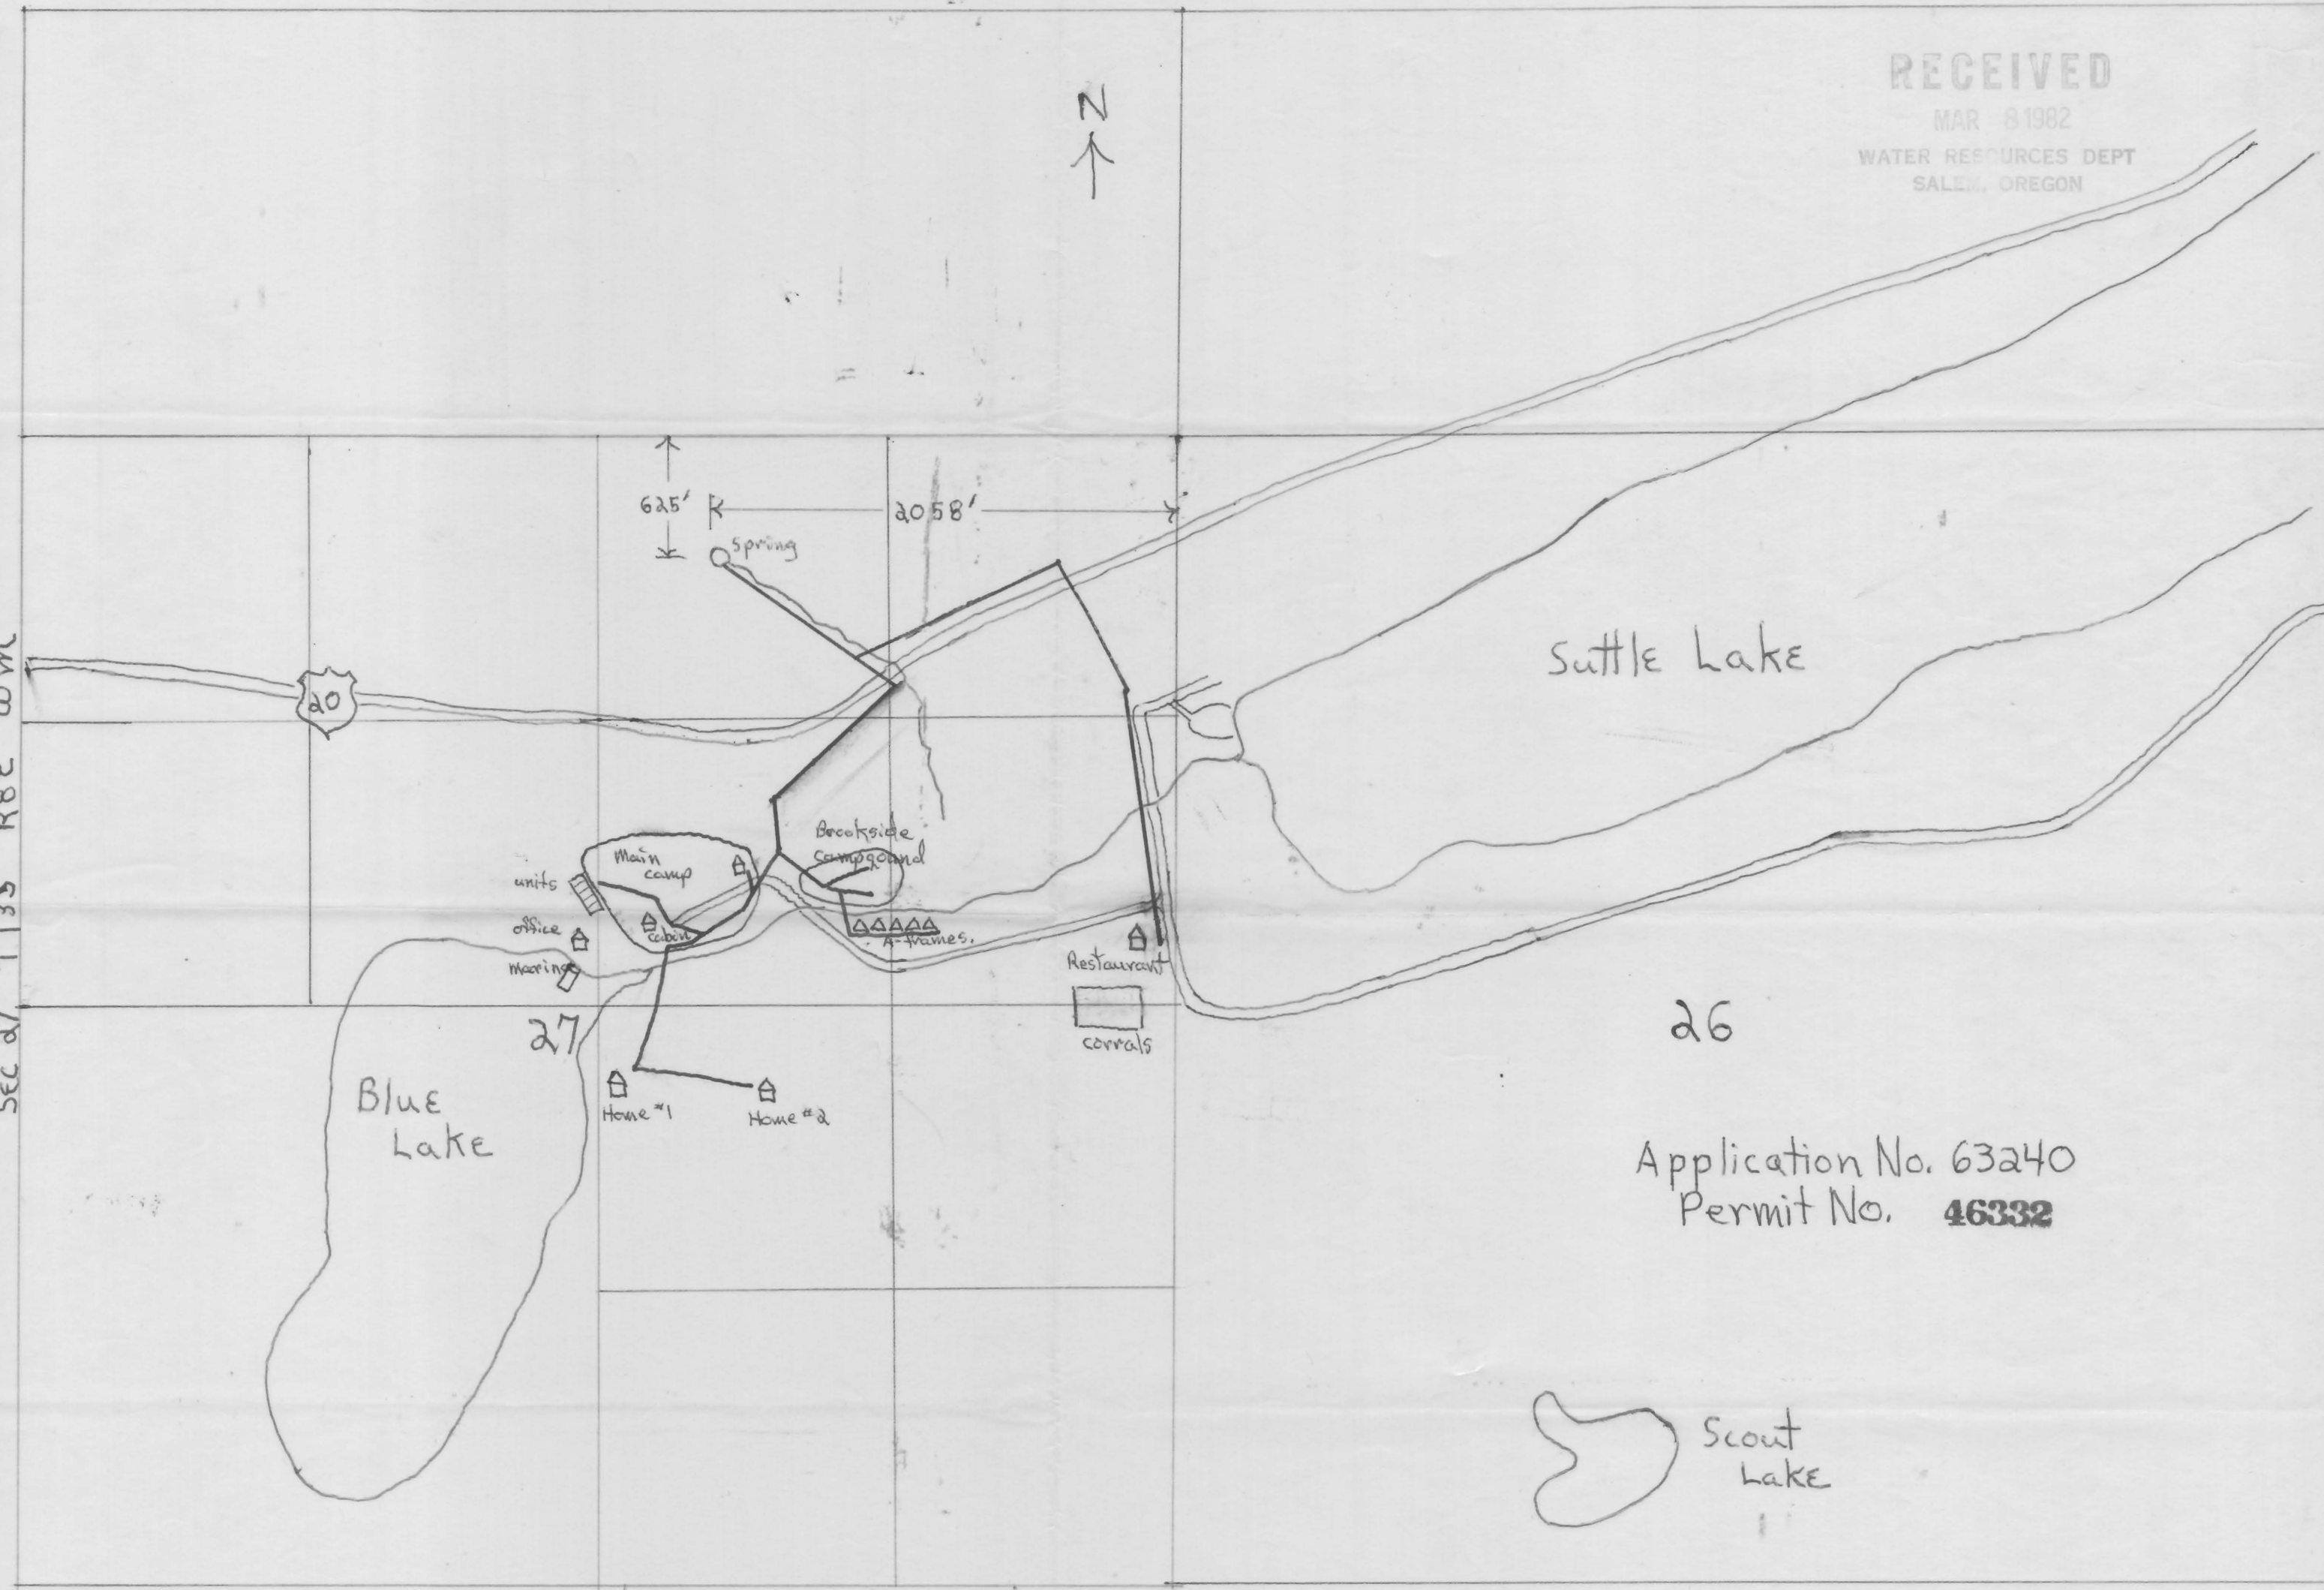

625' R
Spring

2058'

Suttle Lake

Blue Lake

Main camp
Brookside Campground
A-frames

Restaurant
corrals

Home #1
Home #2

26

Application No. 63240
Permit No. 46332

Scout Lake

Roads	_____
Water line	_____
Camps & Resort	_____
Water (lakes & creeks)	_____