


FINAL PROOF MAP
 SW1/4NE1/4 and NW1/4SE1/4 Section 13,
 T. 39 S., R. 3 W., W.M., Jackson County, Oregon
 For
 Bo P. Boyajian
 2639 Little Applegate Road
 Jacksonville, OR. 97530

T. 39 S., R. 3 W., Sec. 13

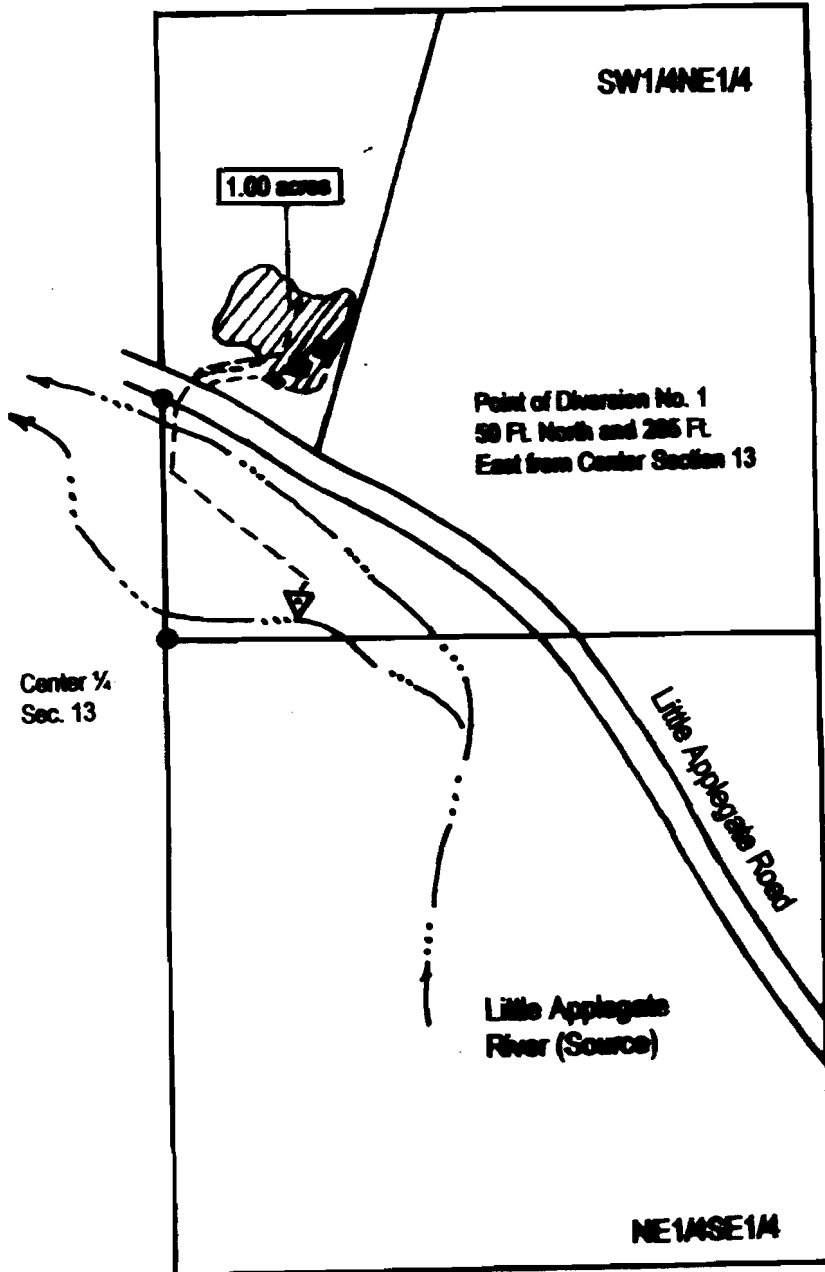

LEGEND



Date: July 21, 2005

Scale: 1" = 400'

- Found Survey Monument
- Denotes Building



Denotes area under Special Order
 Volume 98, Pages 2178-2180, Priority
 Date October 23, 1980.

Certified Water Right Examiner
 HAROLD L. CENTER, P.L.S., C.W.R.E.
 2804 David Lane - Medford, OR. 97504
 541-535-6108, Fax 541-535-8752
 Oregon C.W.R.E. No. 152
 Certificate Renewal Date, 12/31/05

This map was prepared for the purpose of identifying the location of a water right only and is not intended to provide legal dimensions or location of property ownership.

RECEIVED

SEP 21 2005

WATER RESOURCES DEPT
 SALEM, OREGON

