


RECEIVED


FEB 18 1982
WATER RESOURCES DEPT.
SALEM, OREGON

T.5S., R.4W., W.M.

RECEIVED

FEB 4 1981
FEB 4 1981
WATER RESOURCES DEPT.
SALEM, OREGON

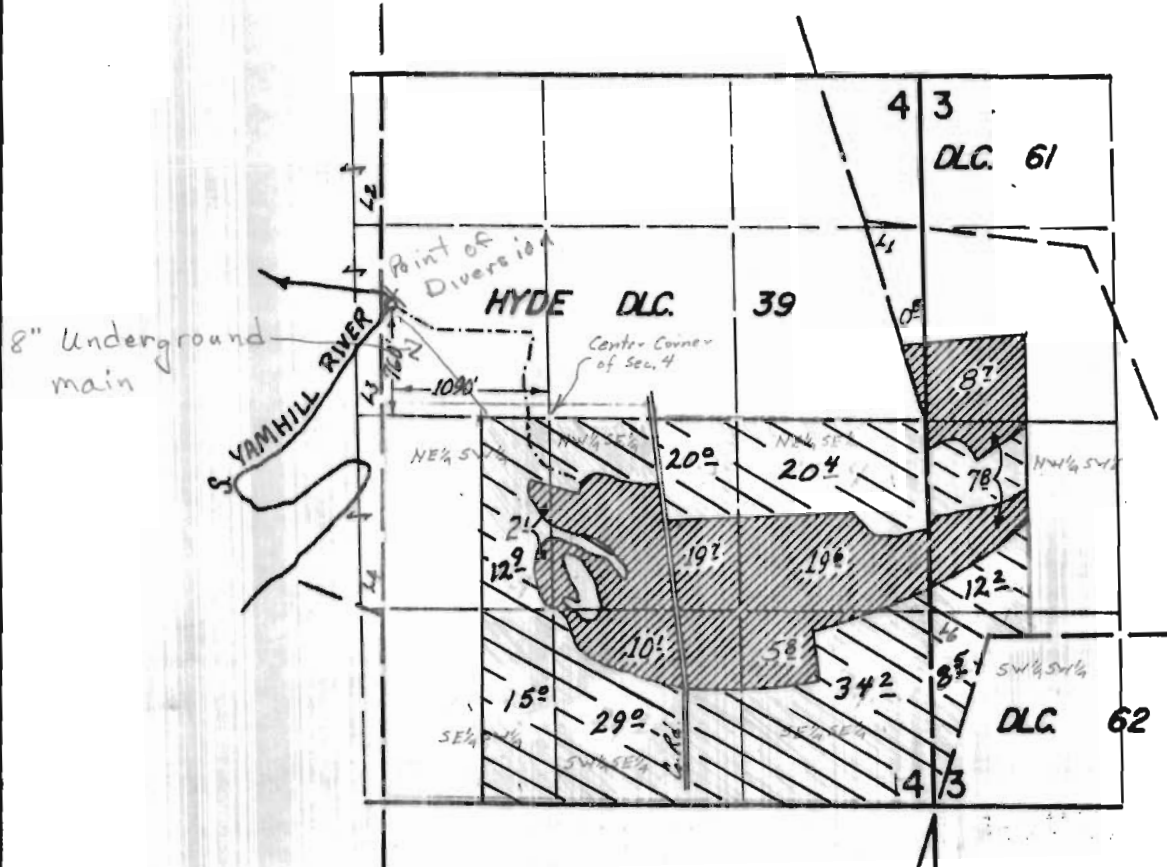

 Land under Cert # 39937

 Land under Appl. 61226

~~FINAL PROOF SURVEY~~
~~UNDER~~

~~Application No. 44183 Permit No. 33012~~

~~IN NAME OF~~

~~JAMES M & ETHELYN BOESE~~

~~Surveyed 14 Nov 1978 by P. Adams~~

Application No. 61226
Permit No. 46335
209-111-122