


Correction Plat

HARRY L. HERYFORD, BUTTE FALLS, JACKSON COUNTY, ORE.
For Final Proof to waters of Willow Creek Jackson
County Oregon, Application 7336 Permit 4637.

November 10th 1926

TP 35.5. R 3 E. W. 11

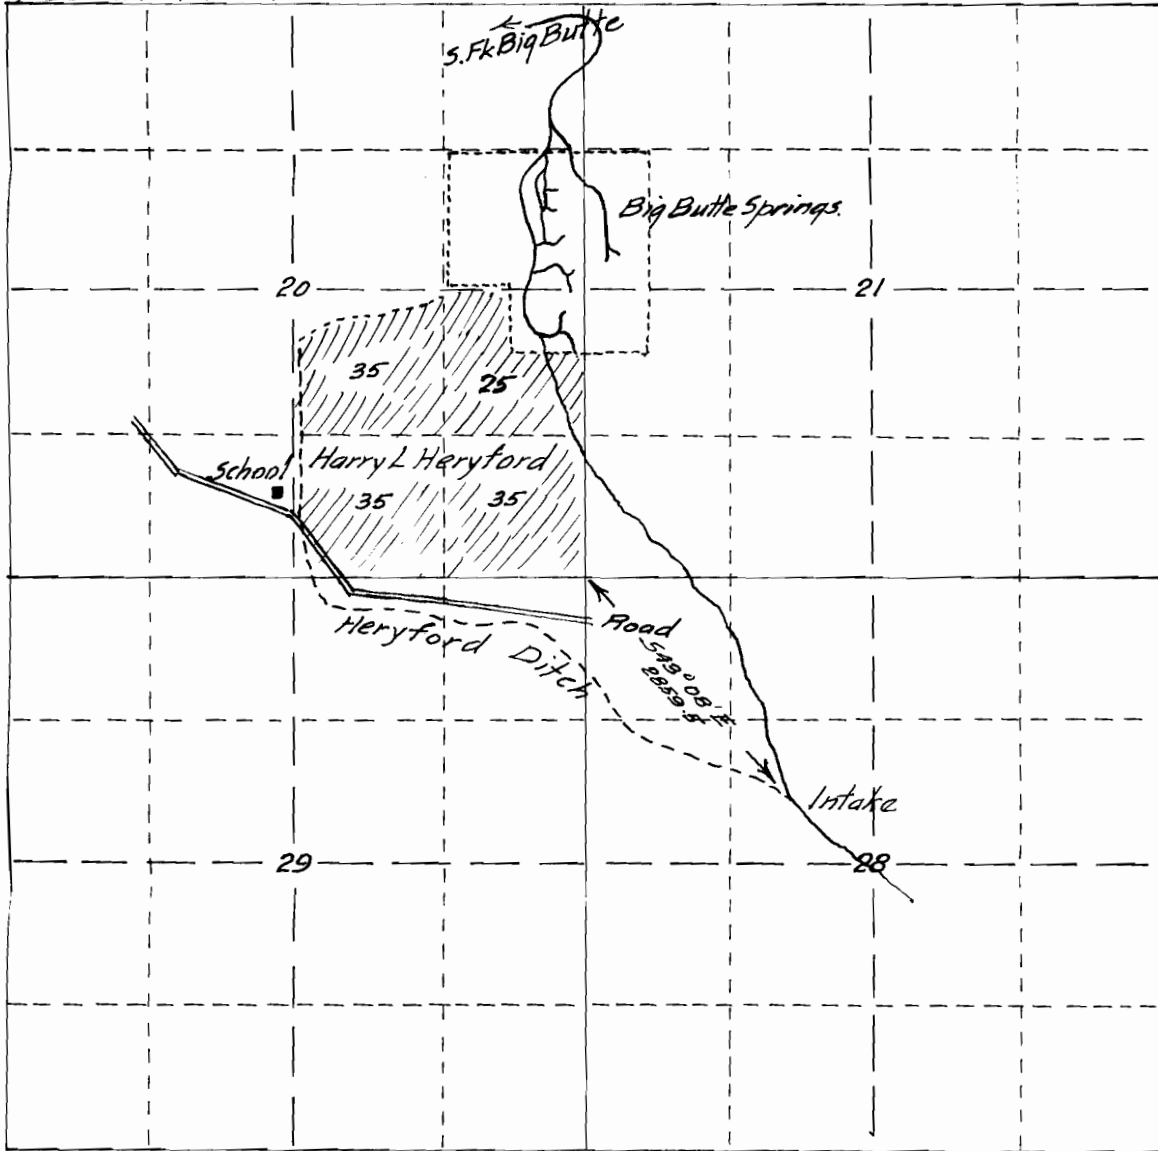

Examined for final proof. November 10th 1926
by Fred. N. Cummings. C.E.