


T. 37 S., R. 5 W., W.M.

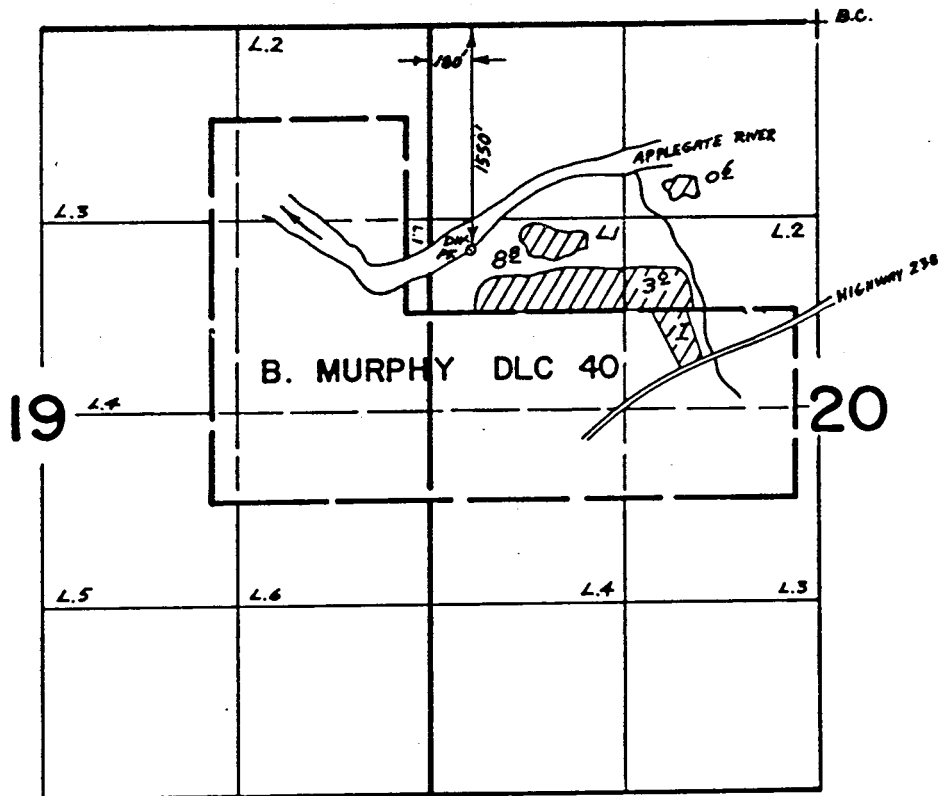

RECEIVED  
MAR 12 1990  
WM. DIST. 14  
GRANTS PASS, ORE.

**FINAL PROOF SURVEY**  
UNDER

TRANSFERS 4230 & 4690

Application No. 62326.. Permit No. 46416.....

IN NAME OF

**HARLAN D. WOOD**  
**MICHAEL WOOD & LOIS TRUELSON**

Surveyed JUNE 16, 1982, by R.R. SUND.....

JULY 20, 1983, by B.S. JAMES

SCALE 4" = 1 MILE

B50-1-3

bsj