


T. 35 S., R. 6 W., W. M.

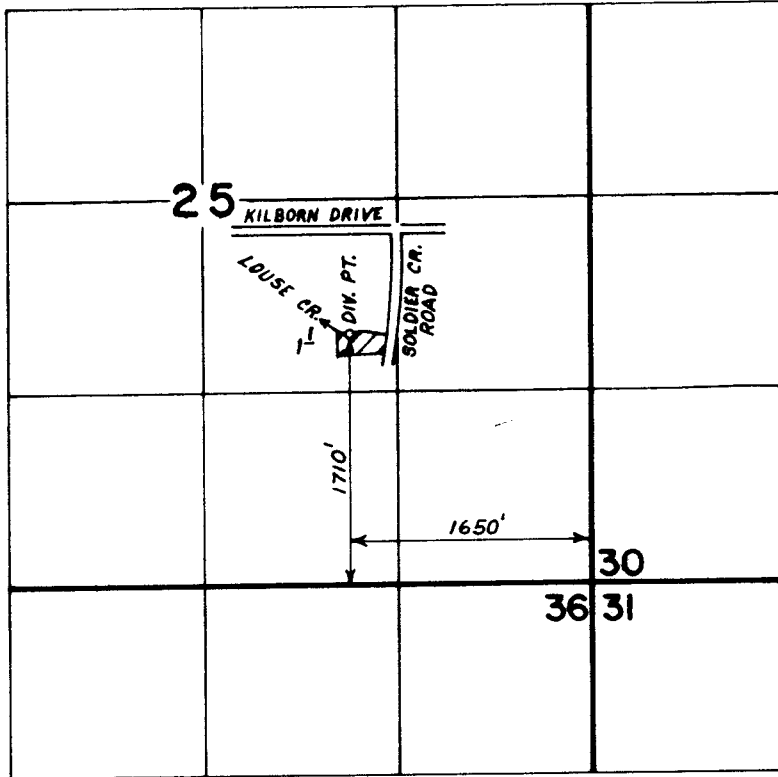

SCALE: 1" = 1320'

RECORDED
SEP 11 1989

REGISTERED TO
B. S. JAMES, SURV.

FINAL PROOF SURVEY
UNDER

Application No. **62353** Permit No. **46417**....
IN NAME OF

.....**THOMAS Q. ROBERTSON**.....

Surveyed **JULY 10, 1984**, by **B. S. JAMES**....