

SECTION 30

NW 1/4, NE 1/4

PT. OF DIVERSION

600 FT S +

2600 FT W of

Oregon State Water Filings

TOWNSHIP 10S, RANGE 26E, W. M.


NE CORNER, SEC. 30

4" = 1 mile

↑
North

W-4 SPRING #2

15-4523

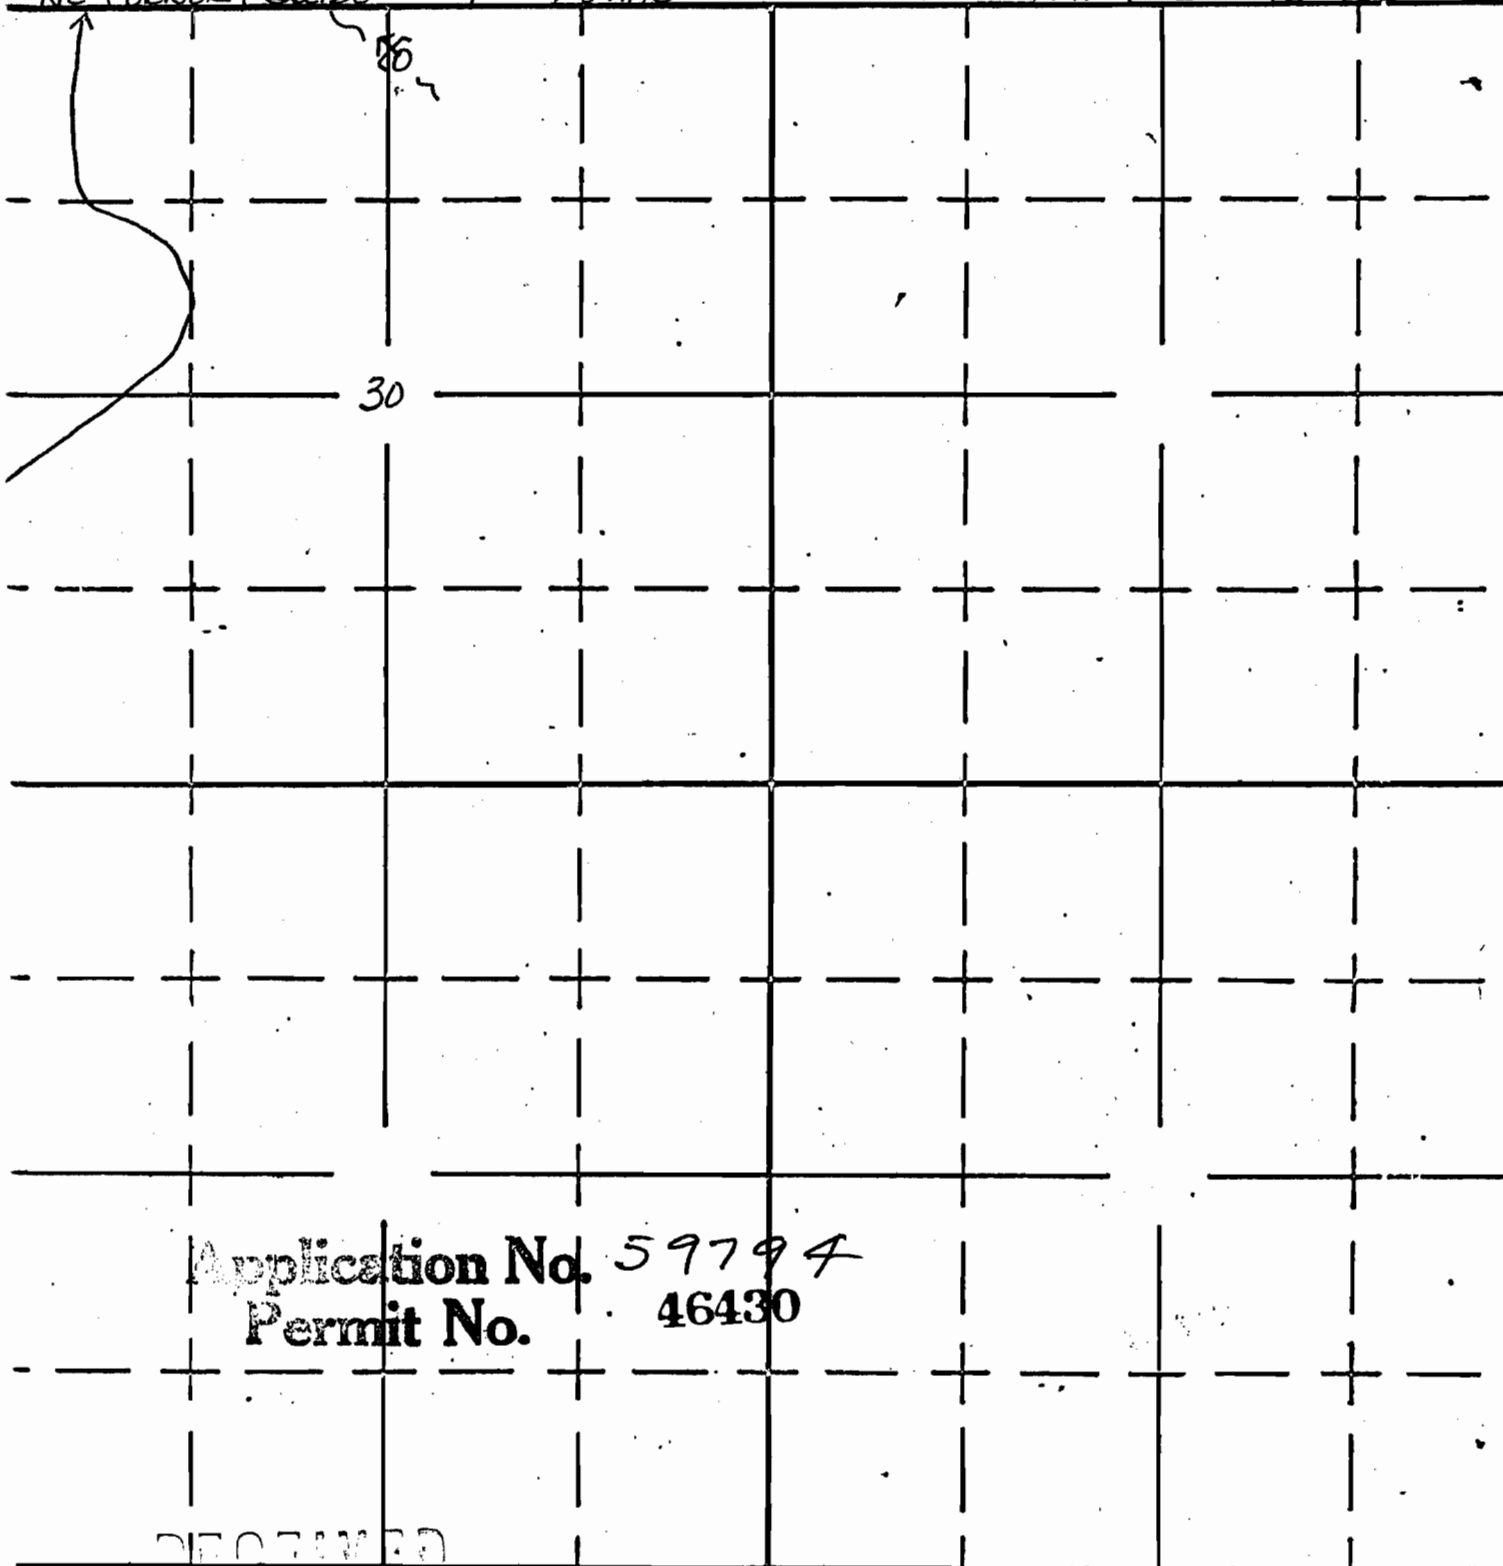

Application No. 59794
 Permit No. 46430

RECEIVED

South

FEB 19 1980

WATER RESOURCES DEPT.
SALEM, OREGON

APPLICATION No.
PERMIT No.