

SECTION 30

Oregon State Water Filings

SE 1/4, SW 1/4

Pt. of DIVERSION

640 ft. N +

1920 ft. E of


TOWNSHIP 10 S, RANGE 26 E, W. M.

SW CORNER, SEC. 30

4" = 1 mile [↑] North

W-4 SPRING #3 15-4524

30

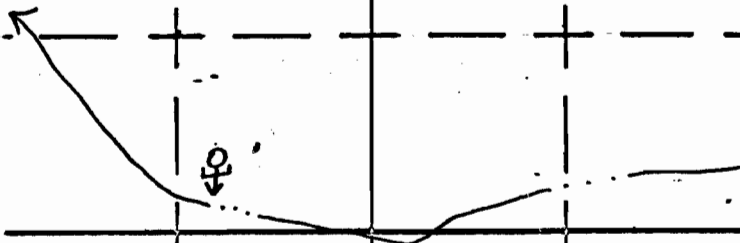

RECEIVED

FEB 19 1990

Application No. 59795
Permit No. 46431

South

WATER RESOURCES DEPT.
SALEM, OREGON

APPLICATION No.
PERMIT No.