

SECTION 7

SW 1/4, NE 1/4



Pt. of DIVERSION

1880 ft. S +


2240 ft. W of

TOWNSHIP 10S, RANGE 26E, W. M.

NE CORNER SEC. 7

4" = 1 mile 

W-4 SPRING #1 15-4522

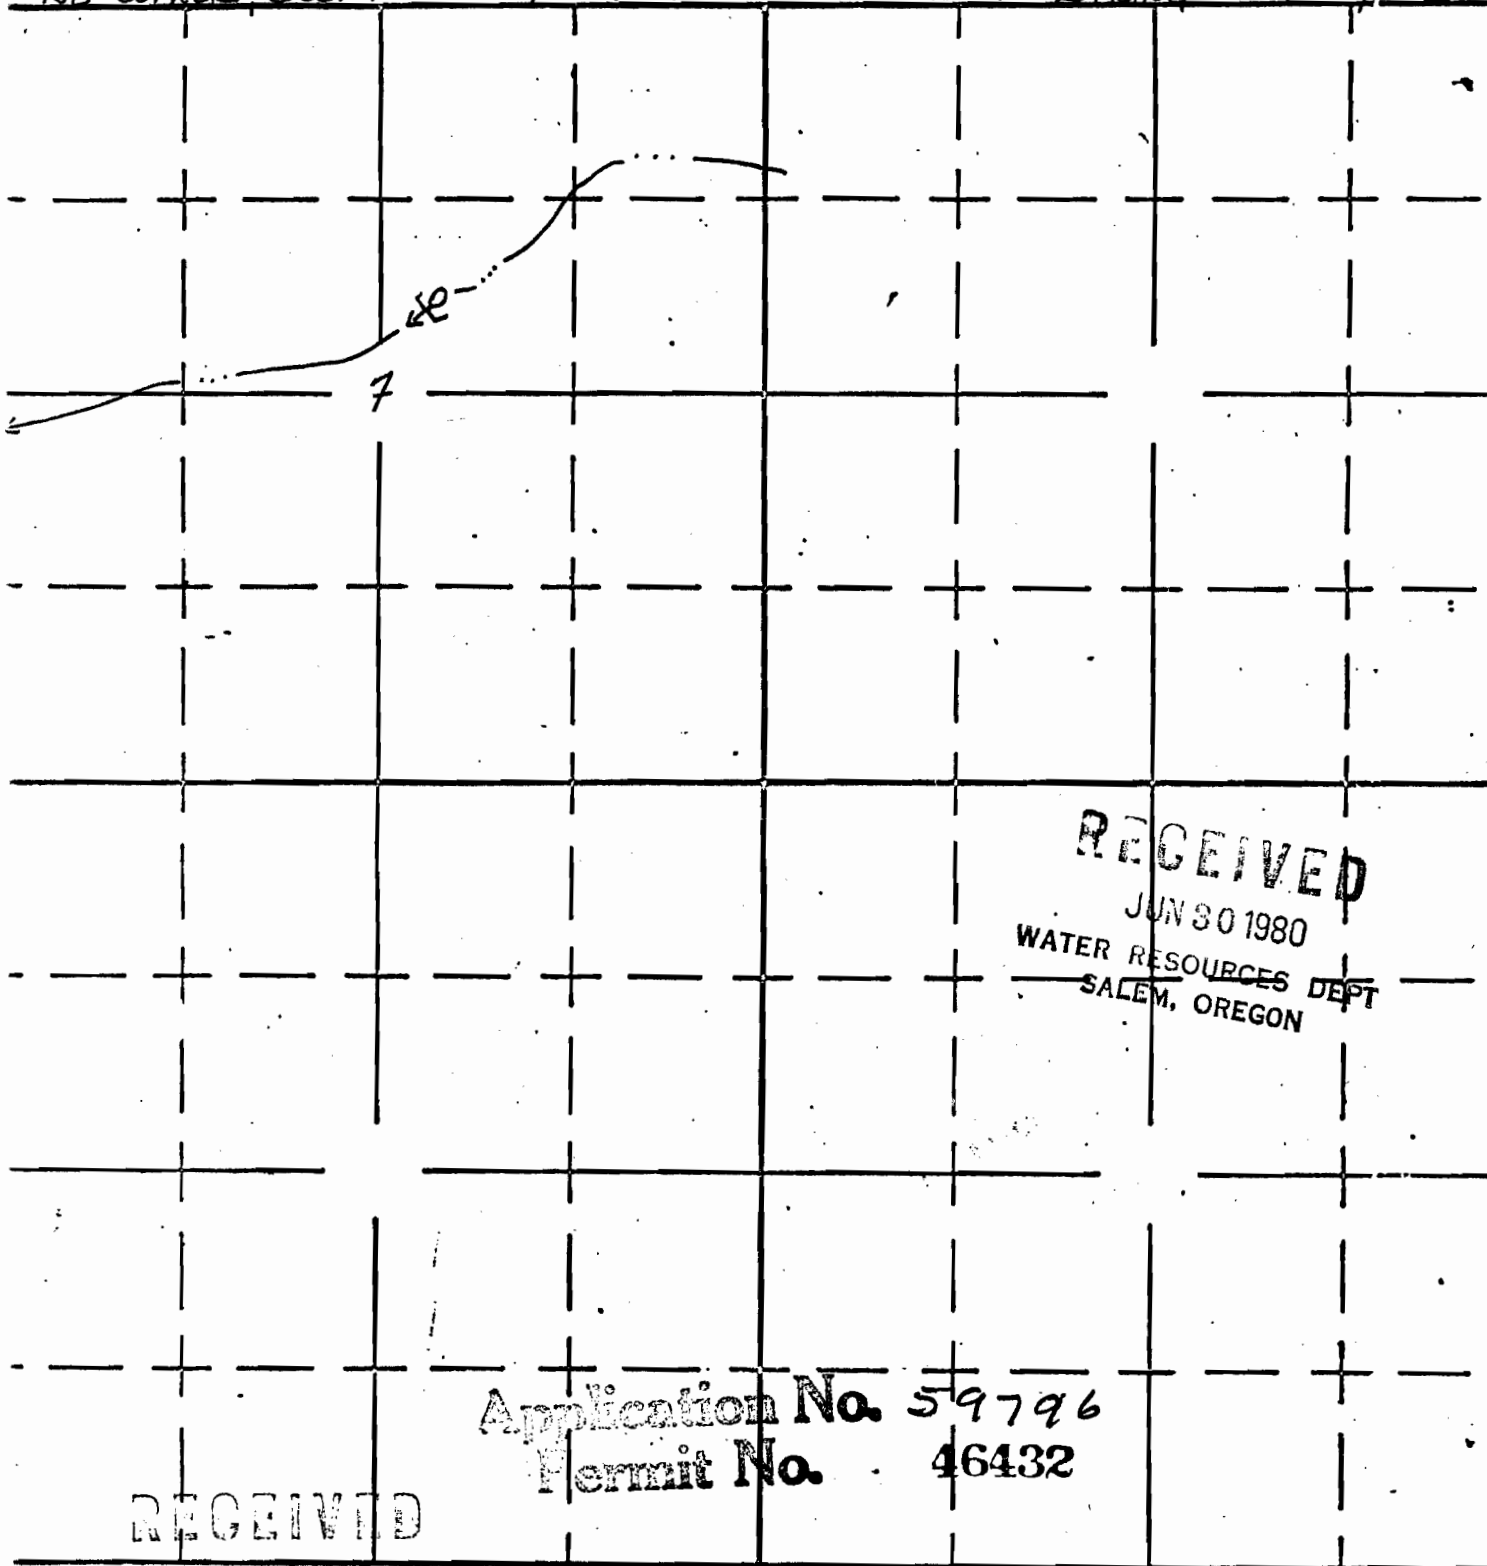

**RECEIVED**  
 JUN 30 1980  
 WATER RESOURCES DEPT  
 SALEM, OREGON

Application No. 59796  
 Permit No. 46432

**RECEIVED**

FEB 10 1980

South

WATER RESOURCES DEPT.  
 SALEM, OREGON

APPLICATION No.  
 PERMIT No.