

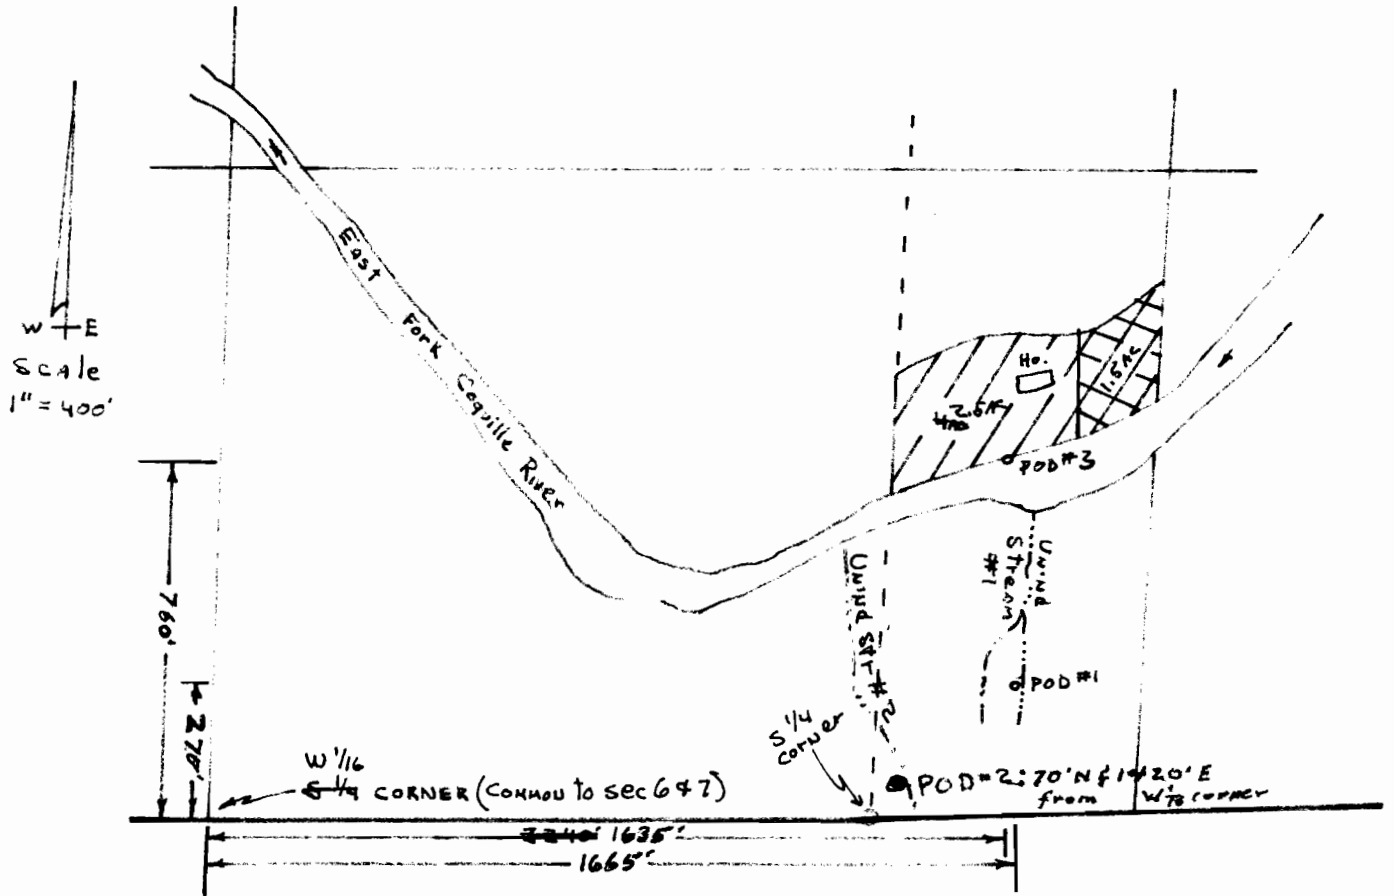
RECEIVED



SEP 24 1981

WATER RESOURCES DEPT
SALEM, OREGON

T28S R10W
SW 1/4 SE 1/4
Sec 6

RECEIVED
WATER RESOURCES DEPT
SALEM, OREGON



-  2.5ac irrigated from Pod#3 (E. Fork Coquille)
-  1.5ac irrigated from POD#2 (Unwind Str #2)

Application No. 60604
No. 46440