


T.37S., R.6W., W.M.

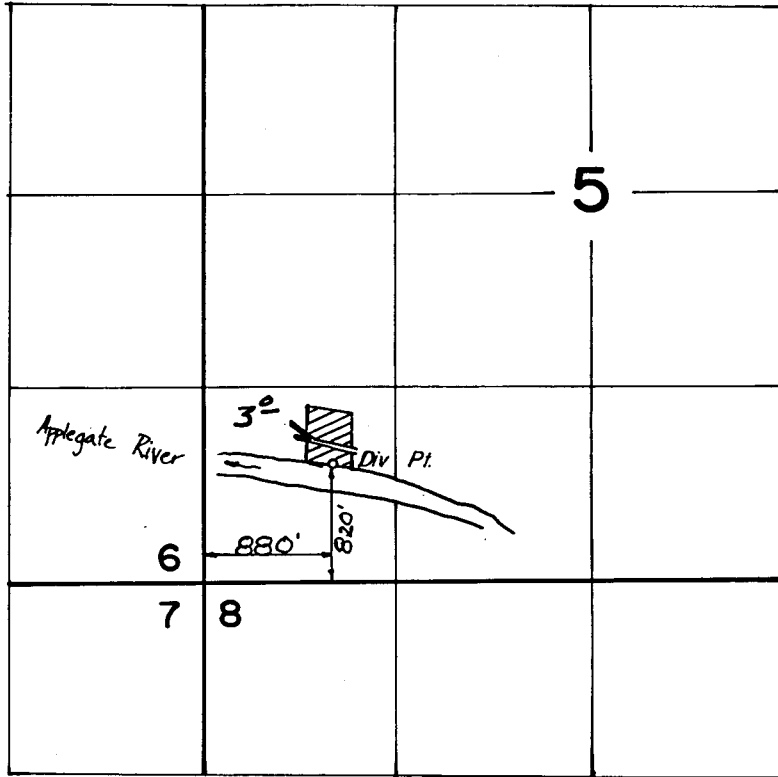

FINAL PROOF SURVEY UNDER

Application No. 6.125.2.. Permit No. 46.4.7.4....
IN NAME OF

.....SPEEDY & EDDIE NUTZ.....

Surveyed AUG 10... 1982., by .B. S. JAMES.....