


46477
41-9-14

T. 41 S., R. 9 W., W. M.

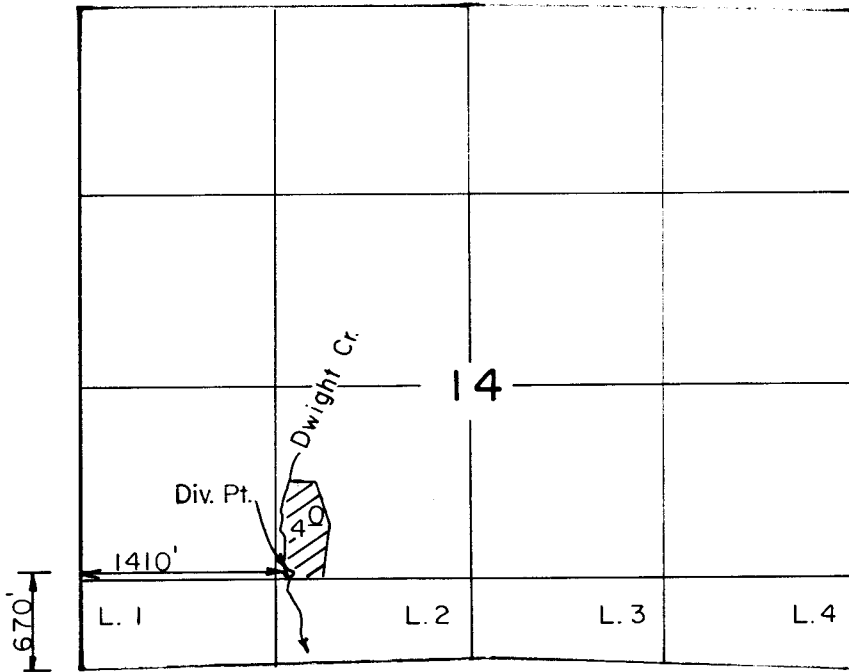

CALIFORNIA

Scale: 1" = 1320'

RECORDED
DEC 1988
COUNTY CLERK

FINAL PROOF SURVEY UNDER

Application No. 61879. Permit No. 46477...
IN NAME OF

.....BURDETTE W. HANCOCK.....

Surveyed APR. 11, 1988, by B. S. JAMES.....