


T.37 S., R.6 W., W.M.

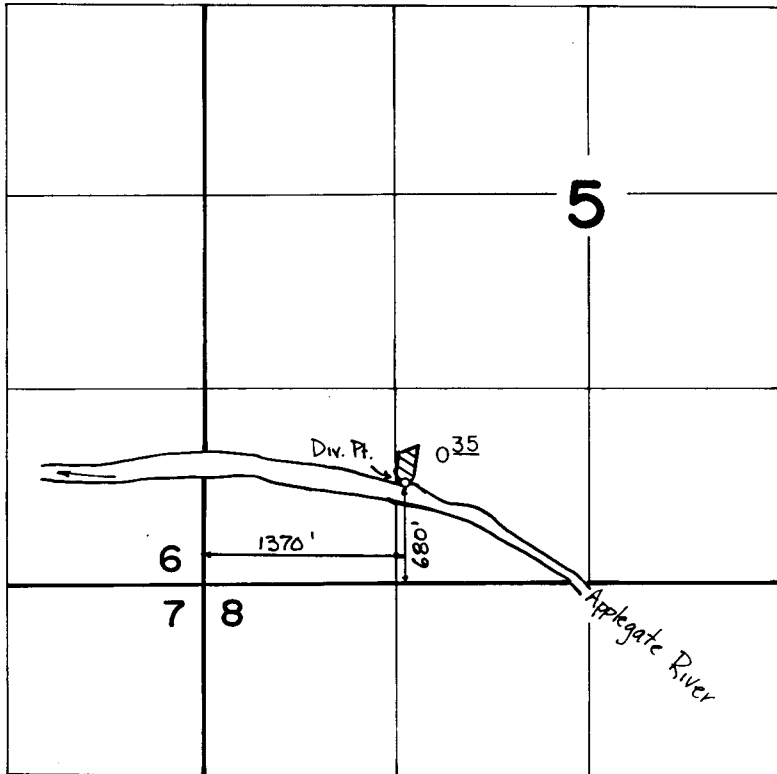

REC'D
AUG 3 1987
SW. DIST. 14

FINAL PROOF SURVEY
UNDER

Application No. 62192.. Permit No. 46485....
IN NAME OF

LEWIS TAGLIERE

Surveyed AUG. 10., 1982., by B. S. JAMES.....

B50-3-11 me 2/89