


T. 37S., R. 6W., W.M.

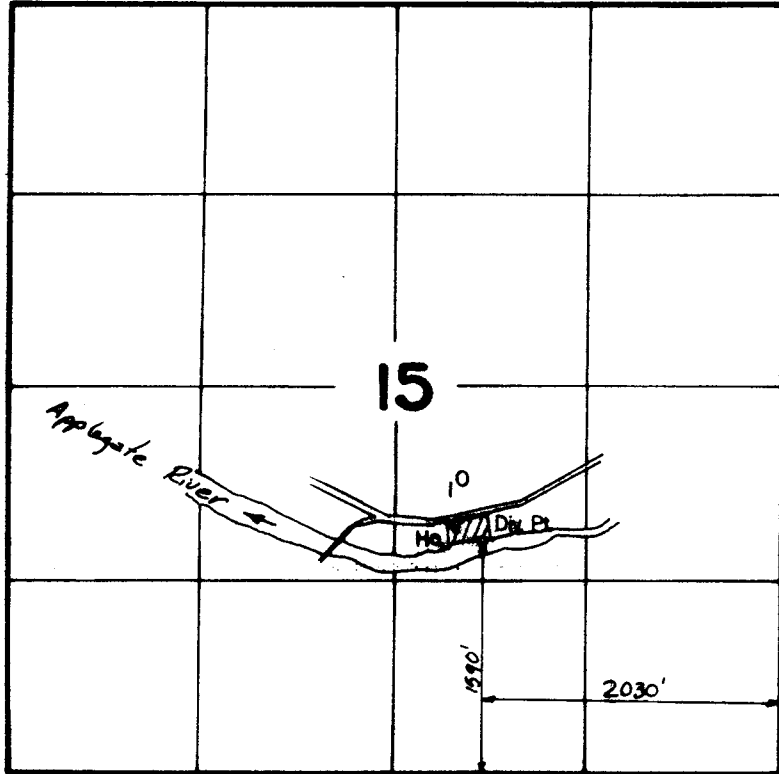

OCT 20 1983

**FINAL PROOF SURVEY
UNDER**

TRANSFER No. 4876

Application No. 62362... Permit No. 46522.....

IN NAME OF

JOHN & MARIA RADCLIFFE

Surveyed OCT. 19, 1983., by B. S. JAMES.....