


T. 37 S., R. 5 W., W.M.

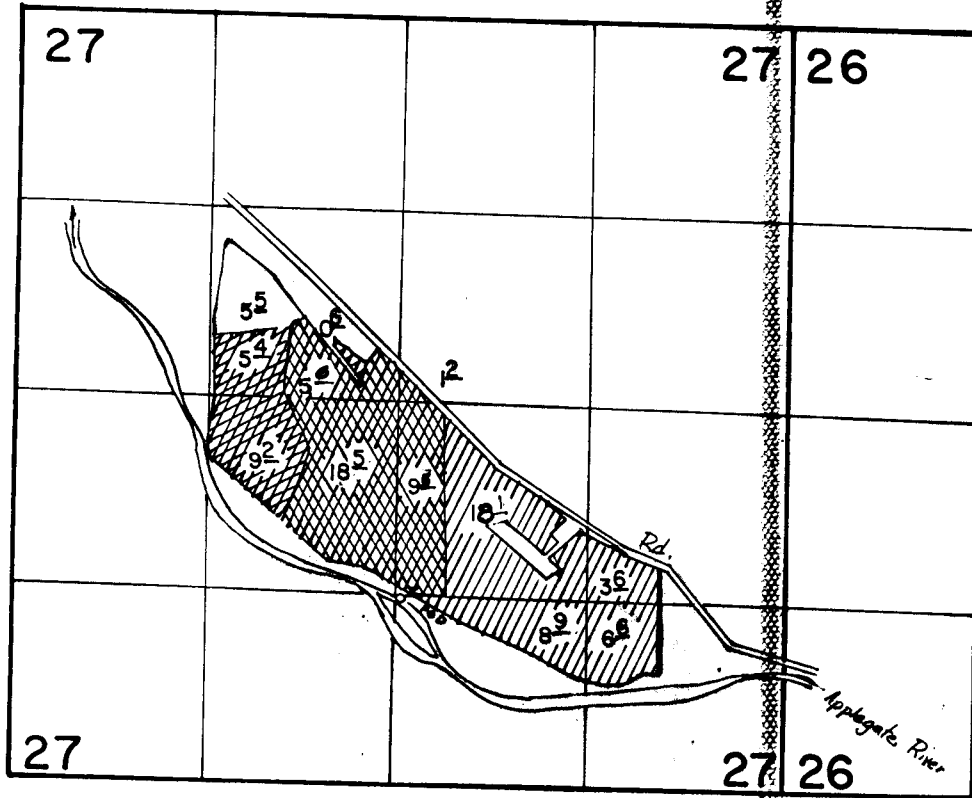

Div. Pt. located 50' S. & 50' E. from N.W corner of
S.W. 1/4 SE. 1/4 Section 27.

FINAL PROOF SURVEY
UNDER

TRANSFER NO. 3734

54190 40714

Application No. 62385 Permit No. 46526

IN NAME OF

primary supplemental
supplemental - Reservation

.....
Surveyed JULY 27, 1982, by B. R. SUND.....

179-110L no. 2/84