


SECTION

TOWNSHIP 38S, RANGE 9W

Permit: S 46535
Volume: 8
Strm: UNN STR
Trib: ILLINOIS R
Priority: 11/14/80

North

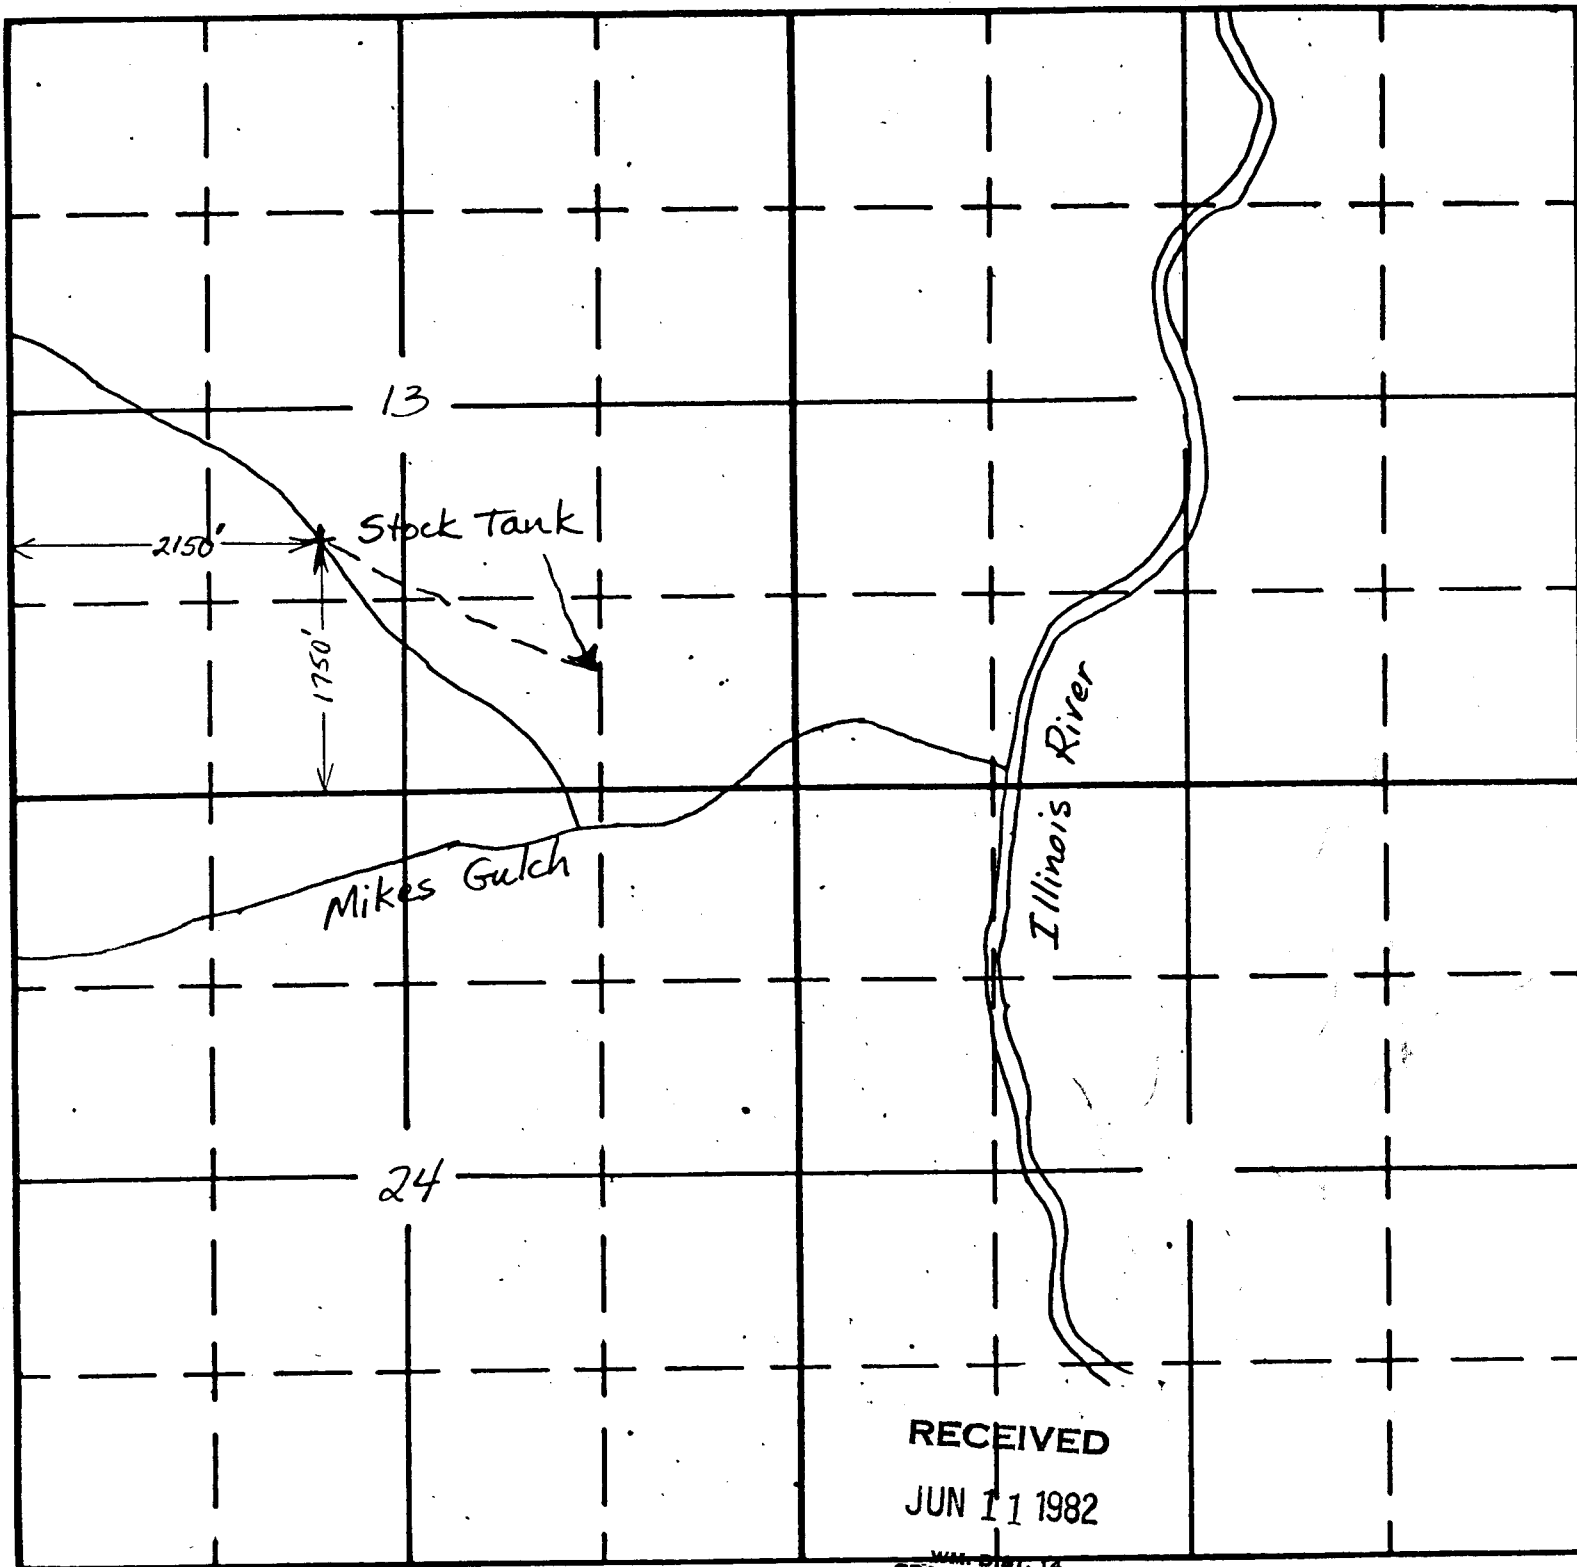

RECEIVED

JUN 11 1982

W.M. DIST. 14
GRANIS PASS, ORE

South

Scale 4" = 1 mile

Application No. 60989

Permit No. 46535