


T. 39S., R. 5 W., W. M.

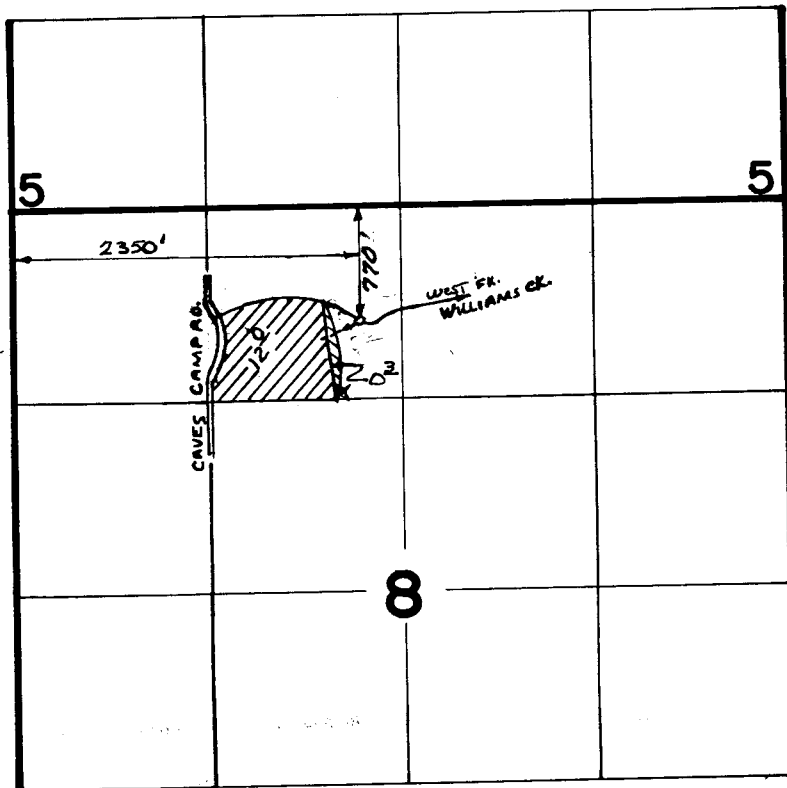

SUPPLEMENTAL ACREAGE



PRIMARY ACREAGE

SCALE : 1" = 1320'

JUL 16 1990

FINAL PROOF SURVEY
UNDER

WM DIST. BY
GRANTS PASS, IRE.

Application No. 61910 Permit No. 46540
IN NAME OF

...SANDRA J. FICKES.....

Surveyed AUG. 14 1984, by B.S. JAMES

41033-179-87R

JRW.