


46555
33-5-29
TL 403

T. 33 S., R. 5 W., W. M.

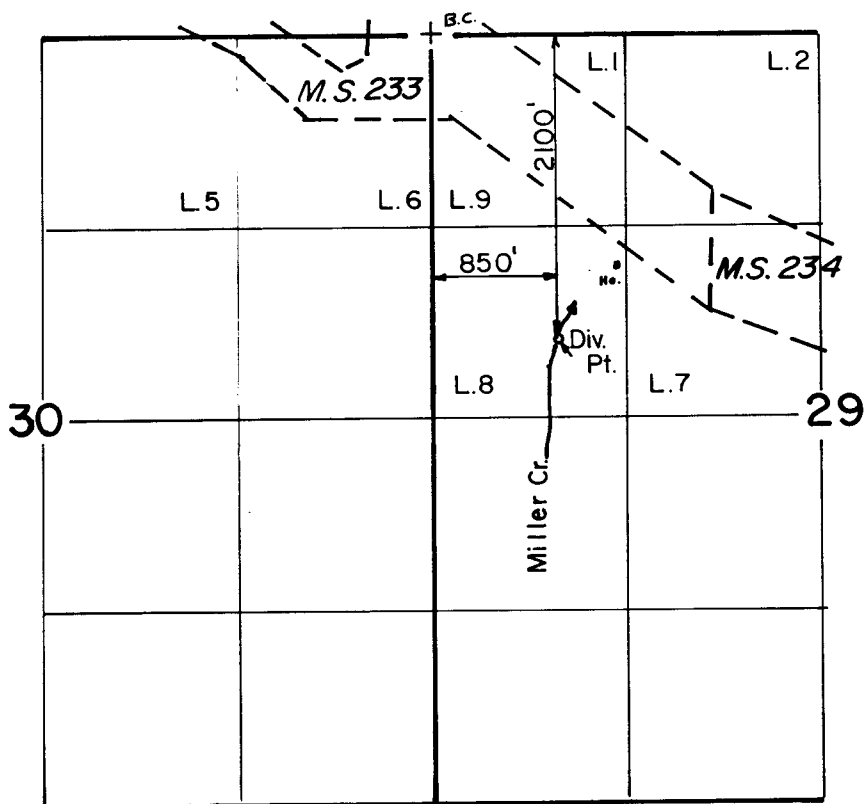

Scale: 1" = 1320'

FINAL PROOF SURVEY
UNDER

Application No. 60853 Permit No. 46555..
IN NAME OF

DOROTHEA.....JUNE.....SPANGRUD

Surveyed MAY.4.. 1989, by B.S...JAMES...

41033-179-129 R
12/9/1983