
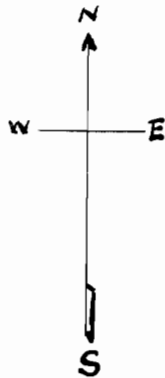


Map
of
Daniels Pipe Line

Application No. 931
Permit No. 466

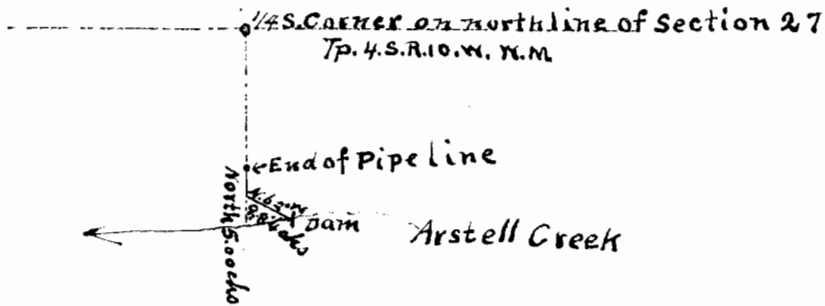

Certificate of Surveyor

I A.M. Austin of Tillamook Oregon do hereby certify that this map was made from notes taken during an actual survey made by me on September 20th 1910. and that it correctly represents the works described in the accompanying application, together with the location of streams and other ditches in the immediate vicinity and has written thereon the area in each smallest legal subdivision which it is proposed to irrigate.

A.M. Austin
Surveyor