


T.37S. R.5&6W. W.M.

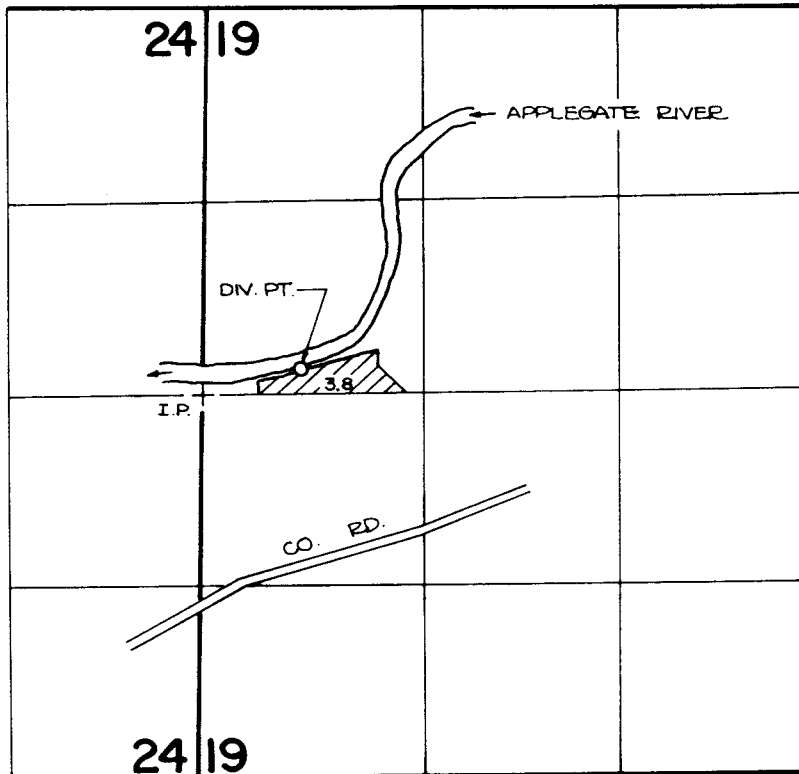

SEP 1 1983

DIVERSION POINT IS LOCATED 2360'S. AND 700'E. FROM THE N.W. CORNER OF SECTION 19.

FINAL PROOF SURVEY
UNDER

Application No. 62327. Permit No. 46623...
IN NAME OF

MICHAEL A. & KATHLEEN E. MILLETTE

Surveyed OCT.13. 1983, by **B. JAMES**