
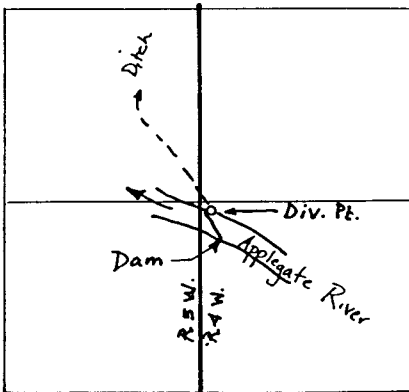


T. 37S., R. 5W., W.M.

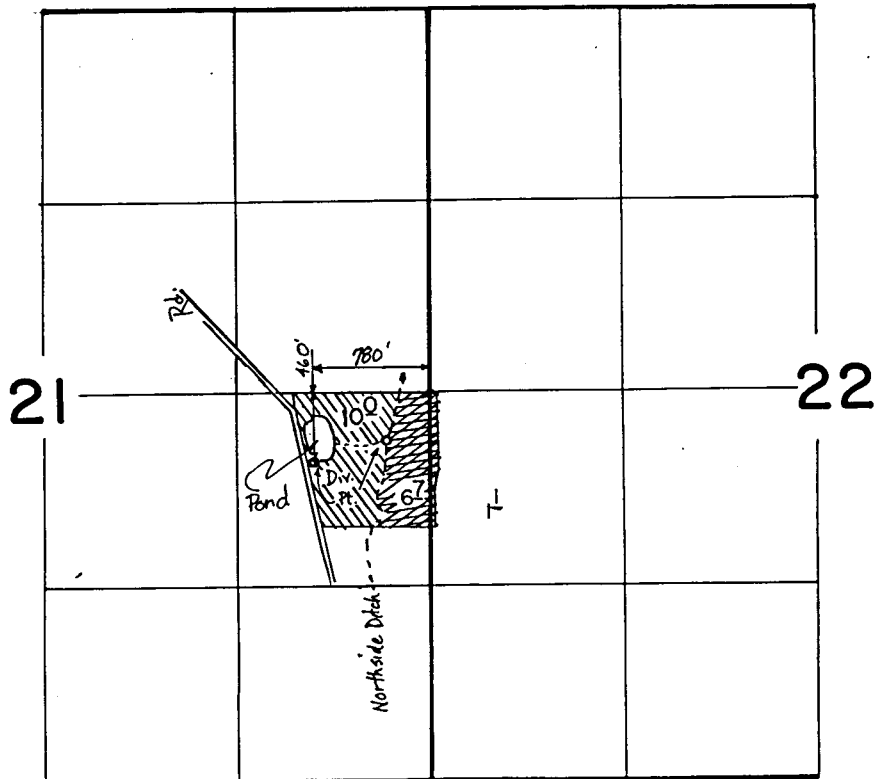

Div. Pt. located 4000' S. &  
80' E. from N.W. Cor.  
Sec. 6, T. 38S., R. 4W.

Scale: 4" = 1 mile

**FINAL PROOF SURVEY**  
UNDER

|                        |                   |  |
|------------------------|-------------------|--|
| 63416                  | 46770             |  |
| 62349                  | 46624             |  |
| Application No. G-8896 | Permit No. G-8313 |  |

IN NAME OF

**EDGAR C. & PHYLLIS M. OWEN**

Surveyed Mar. 29, 1982, by Bruce R. Sund.  
Aug. 18, 1983, B. S. JAMES