ASSUMES NO LIAB Y FOR ANY VARIATIONS AS MAY BE DISCLOSED BY ACTUAL SURVEY

**Title Insurance Company of Oregon**

112-11th Street (Corner of Main) – Oregon City, Oregon 97045

ORDER NO._____
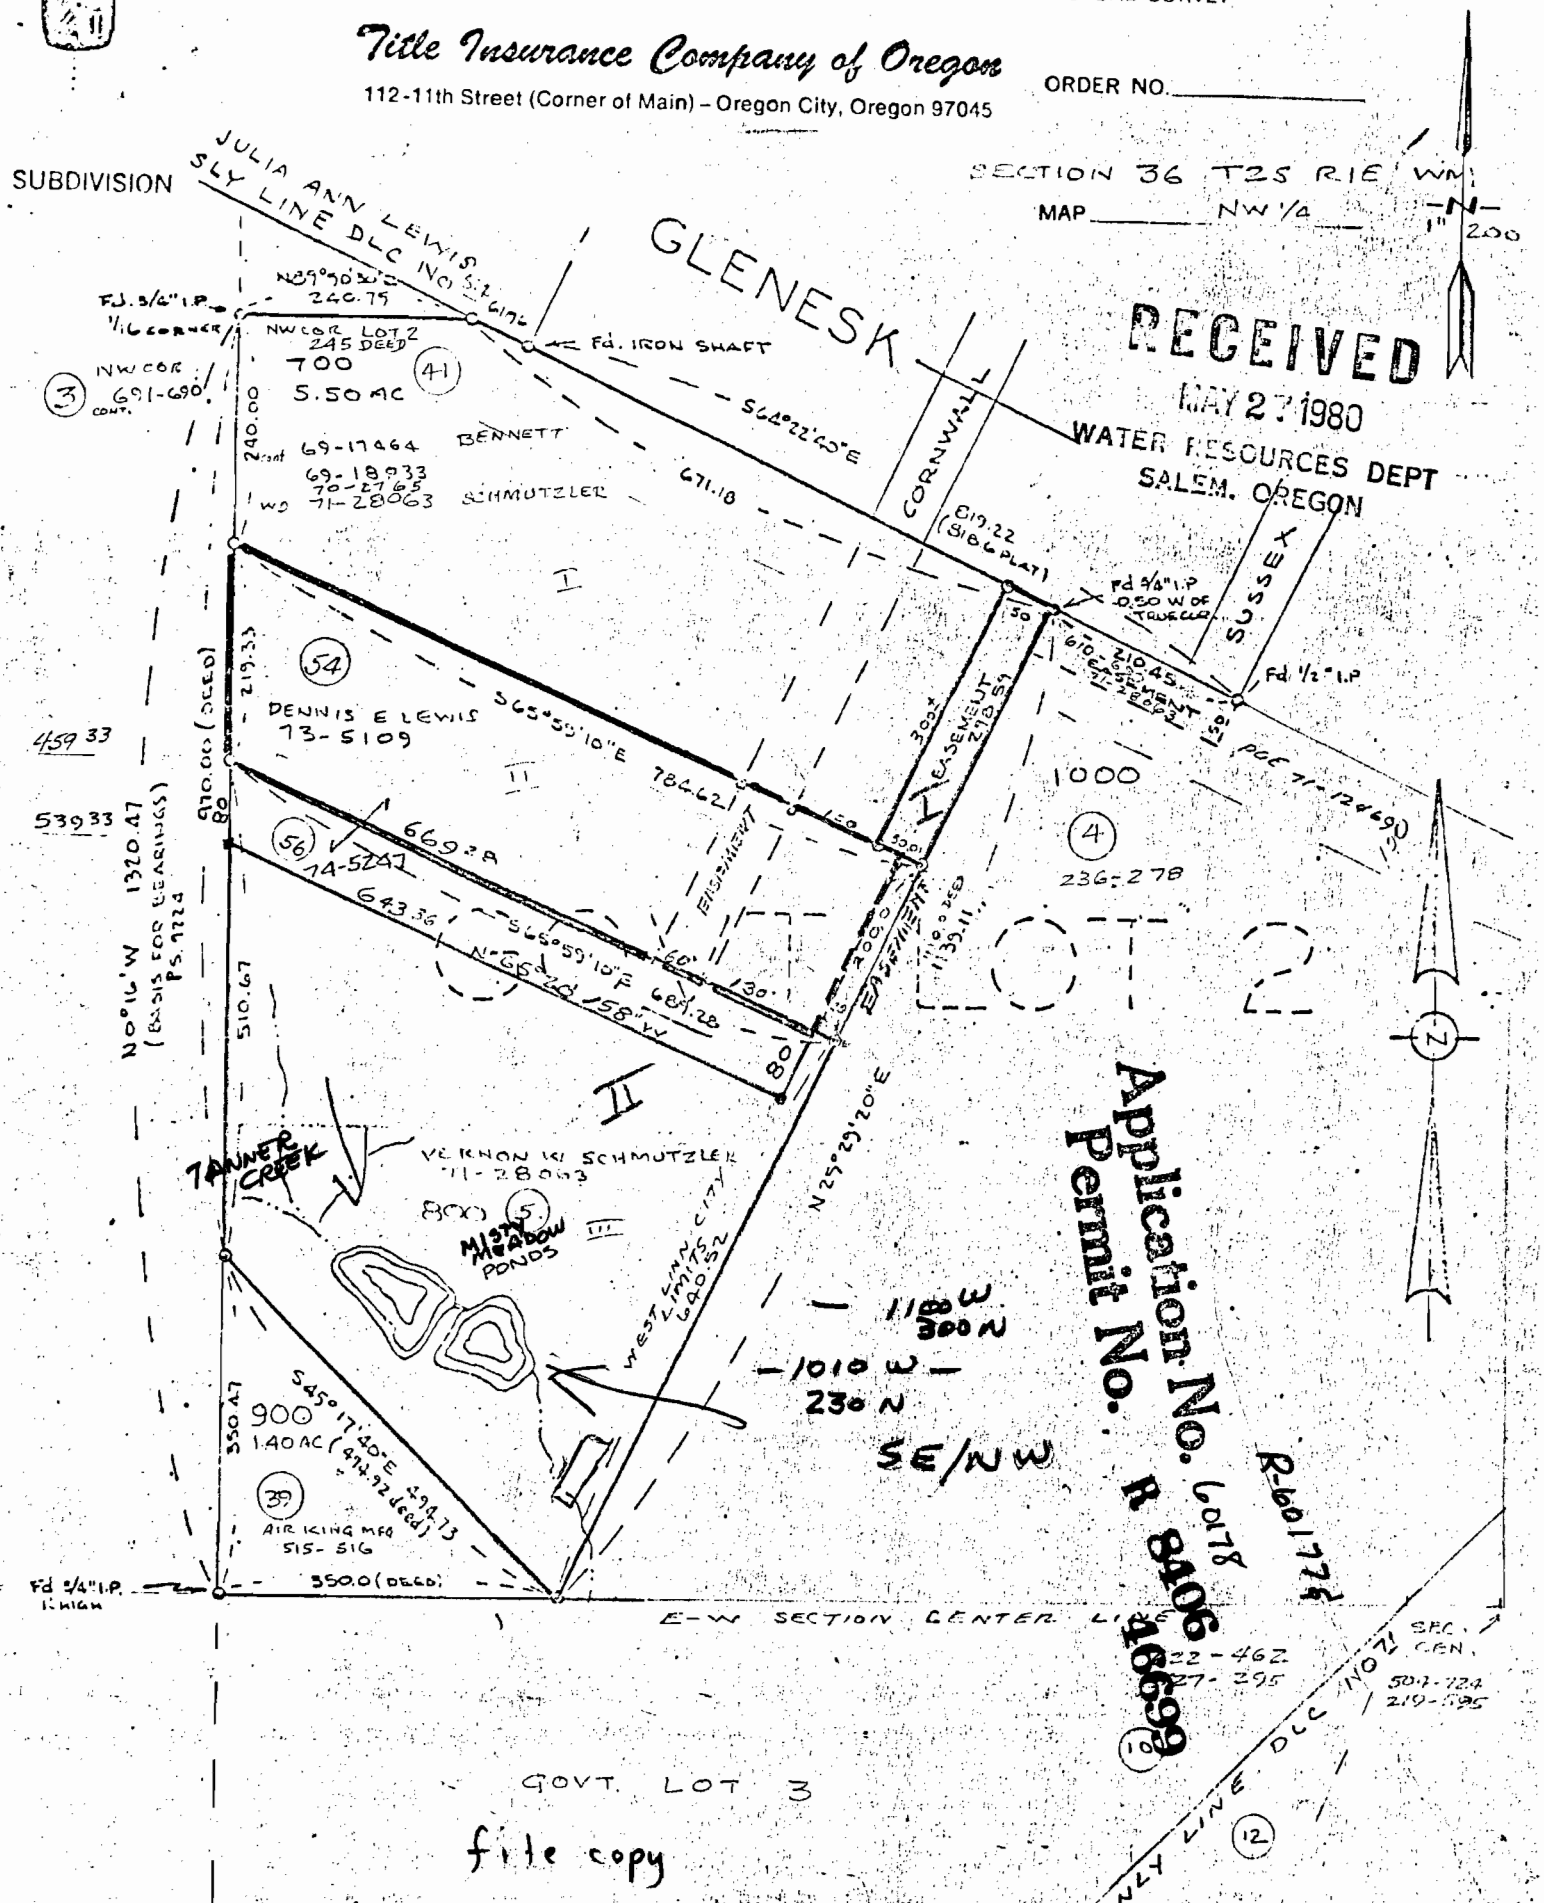
SUBDIVISION