


T. 37 S., R. 6 W., W. M.

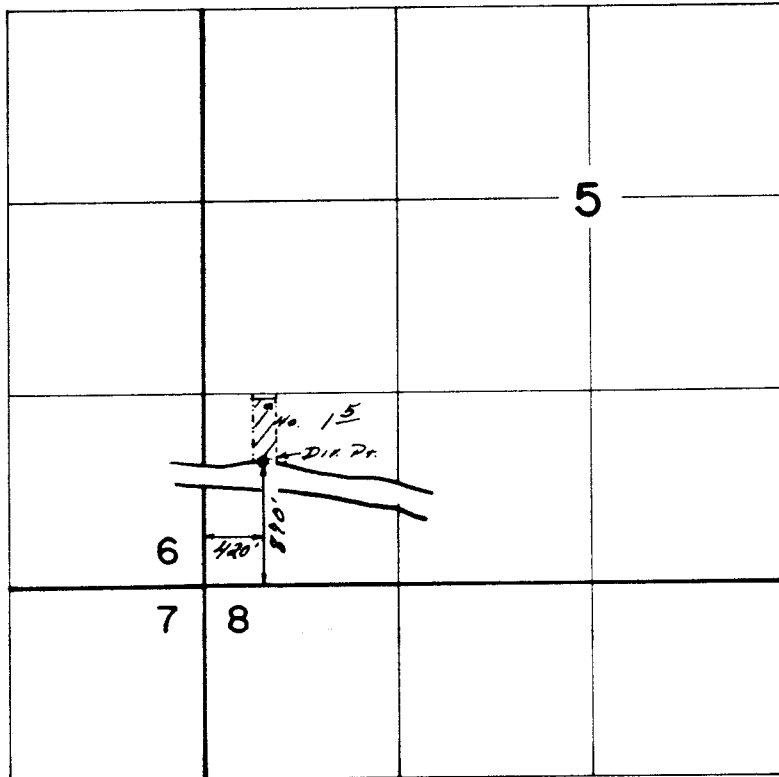

Scale: 1" = 1320'

REC'D

DEC 5 1988

W.M. DIST. 14
GRANTS PARCEL OFFICE

FINAL PROOF SURVEY
UNDER

63250 46709
Application No. **65824** Permit No. **48024**...
IN NAME OF

JOSEPH J. ORRIO

Surveyed JUL...31... 1986, by B....S....JAMES.