


T. 37 S., R. 6 W., W.M.

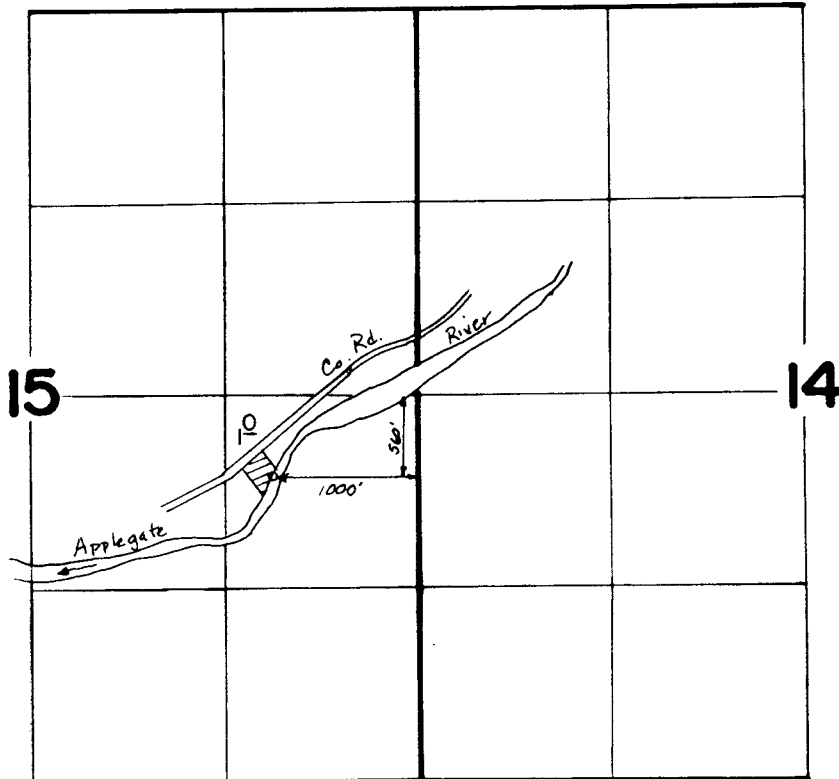

SEP 18 1989

FINAL PROOF SURVEY
UNDER

Application No. 62379.. Permit No. 46738.....
IN NAME OF

PETER VAN WAARDENBERG

Surveyed OCT. 19 1983, by B. S. JAMES.....

B50-2-6 mc/1/84