


Permit: S 46739  
Volume: 6  
Strm: APPEL GATE LAKE RE:  
Trib: APPEL GATE R  
Priority: 8/24/81

WATER RESOURCES DEPT  
SALEM, OREGON

T.37S., R.5W., W.M.

37-5-21

Application No. 62386  
Permit No. 46739

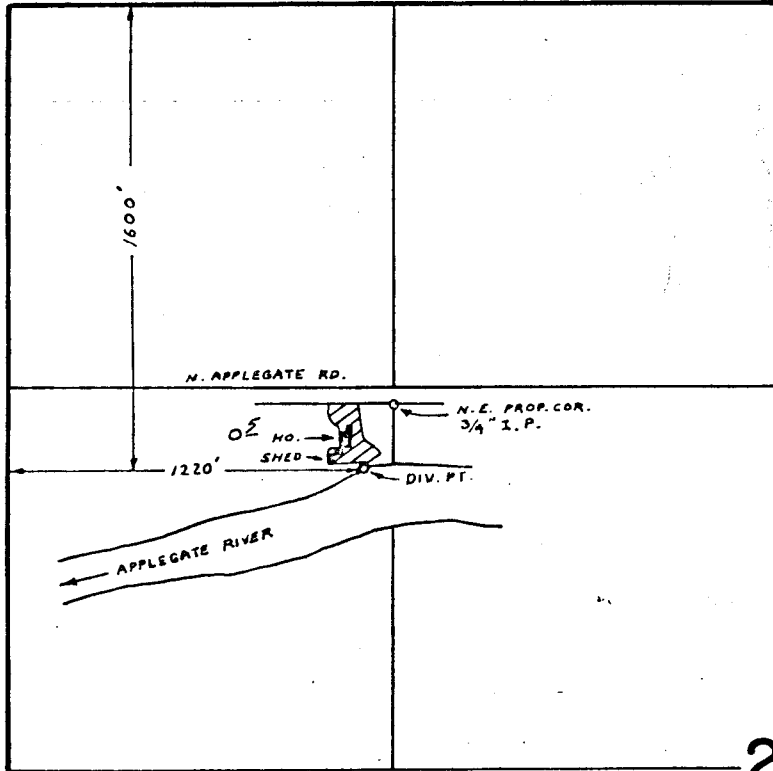

21 from Applg f  
Reservoir  
Supplemental  
to

SCALE: 1" = 660 FT.

**FINAL PROOF SURVEY**  
UNDER

RECEIVED  
JUL 29 1982  
WM. DIST. 14  
GRANTS PASS, ORB

RECEIVED

NOV 12 1981  
WATER RESOURCES DEPT  
SALEM, OREGON

Application No. 53837 Permit No. 40185  
IN NAME OF  
C. W. EILERT  
Surveyed JUL. 14 1978 by B. SUND

P.T.S. - 1978-14-A