


For Assessment Office Use Only

$$I'' = 400'$$

See Map 6 9 20

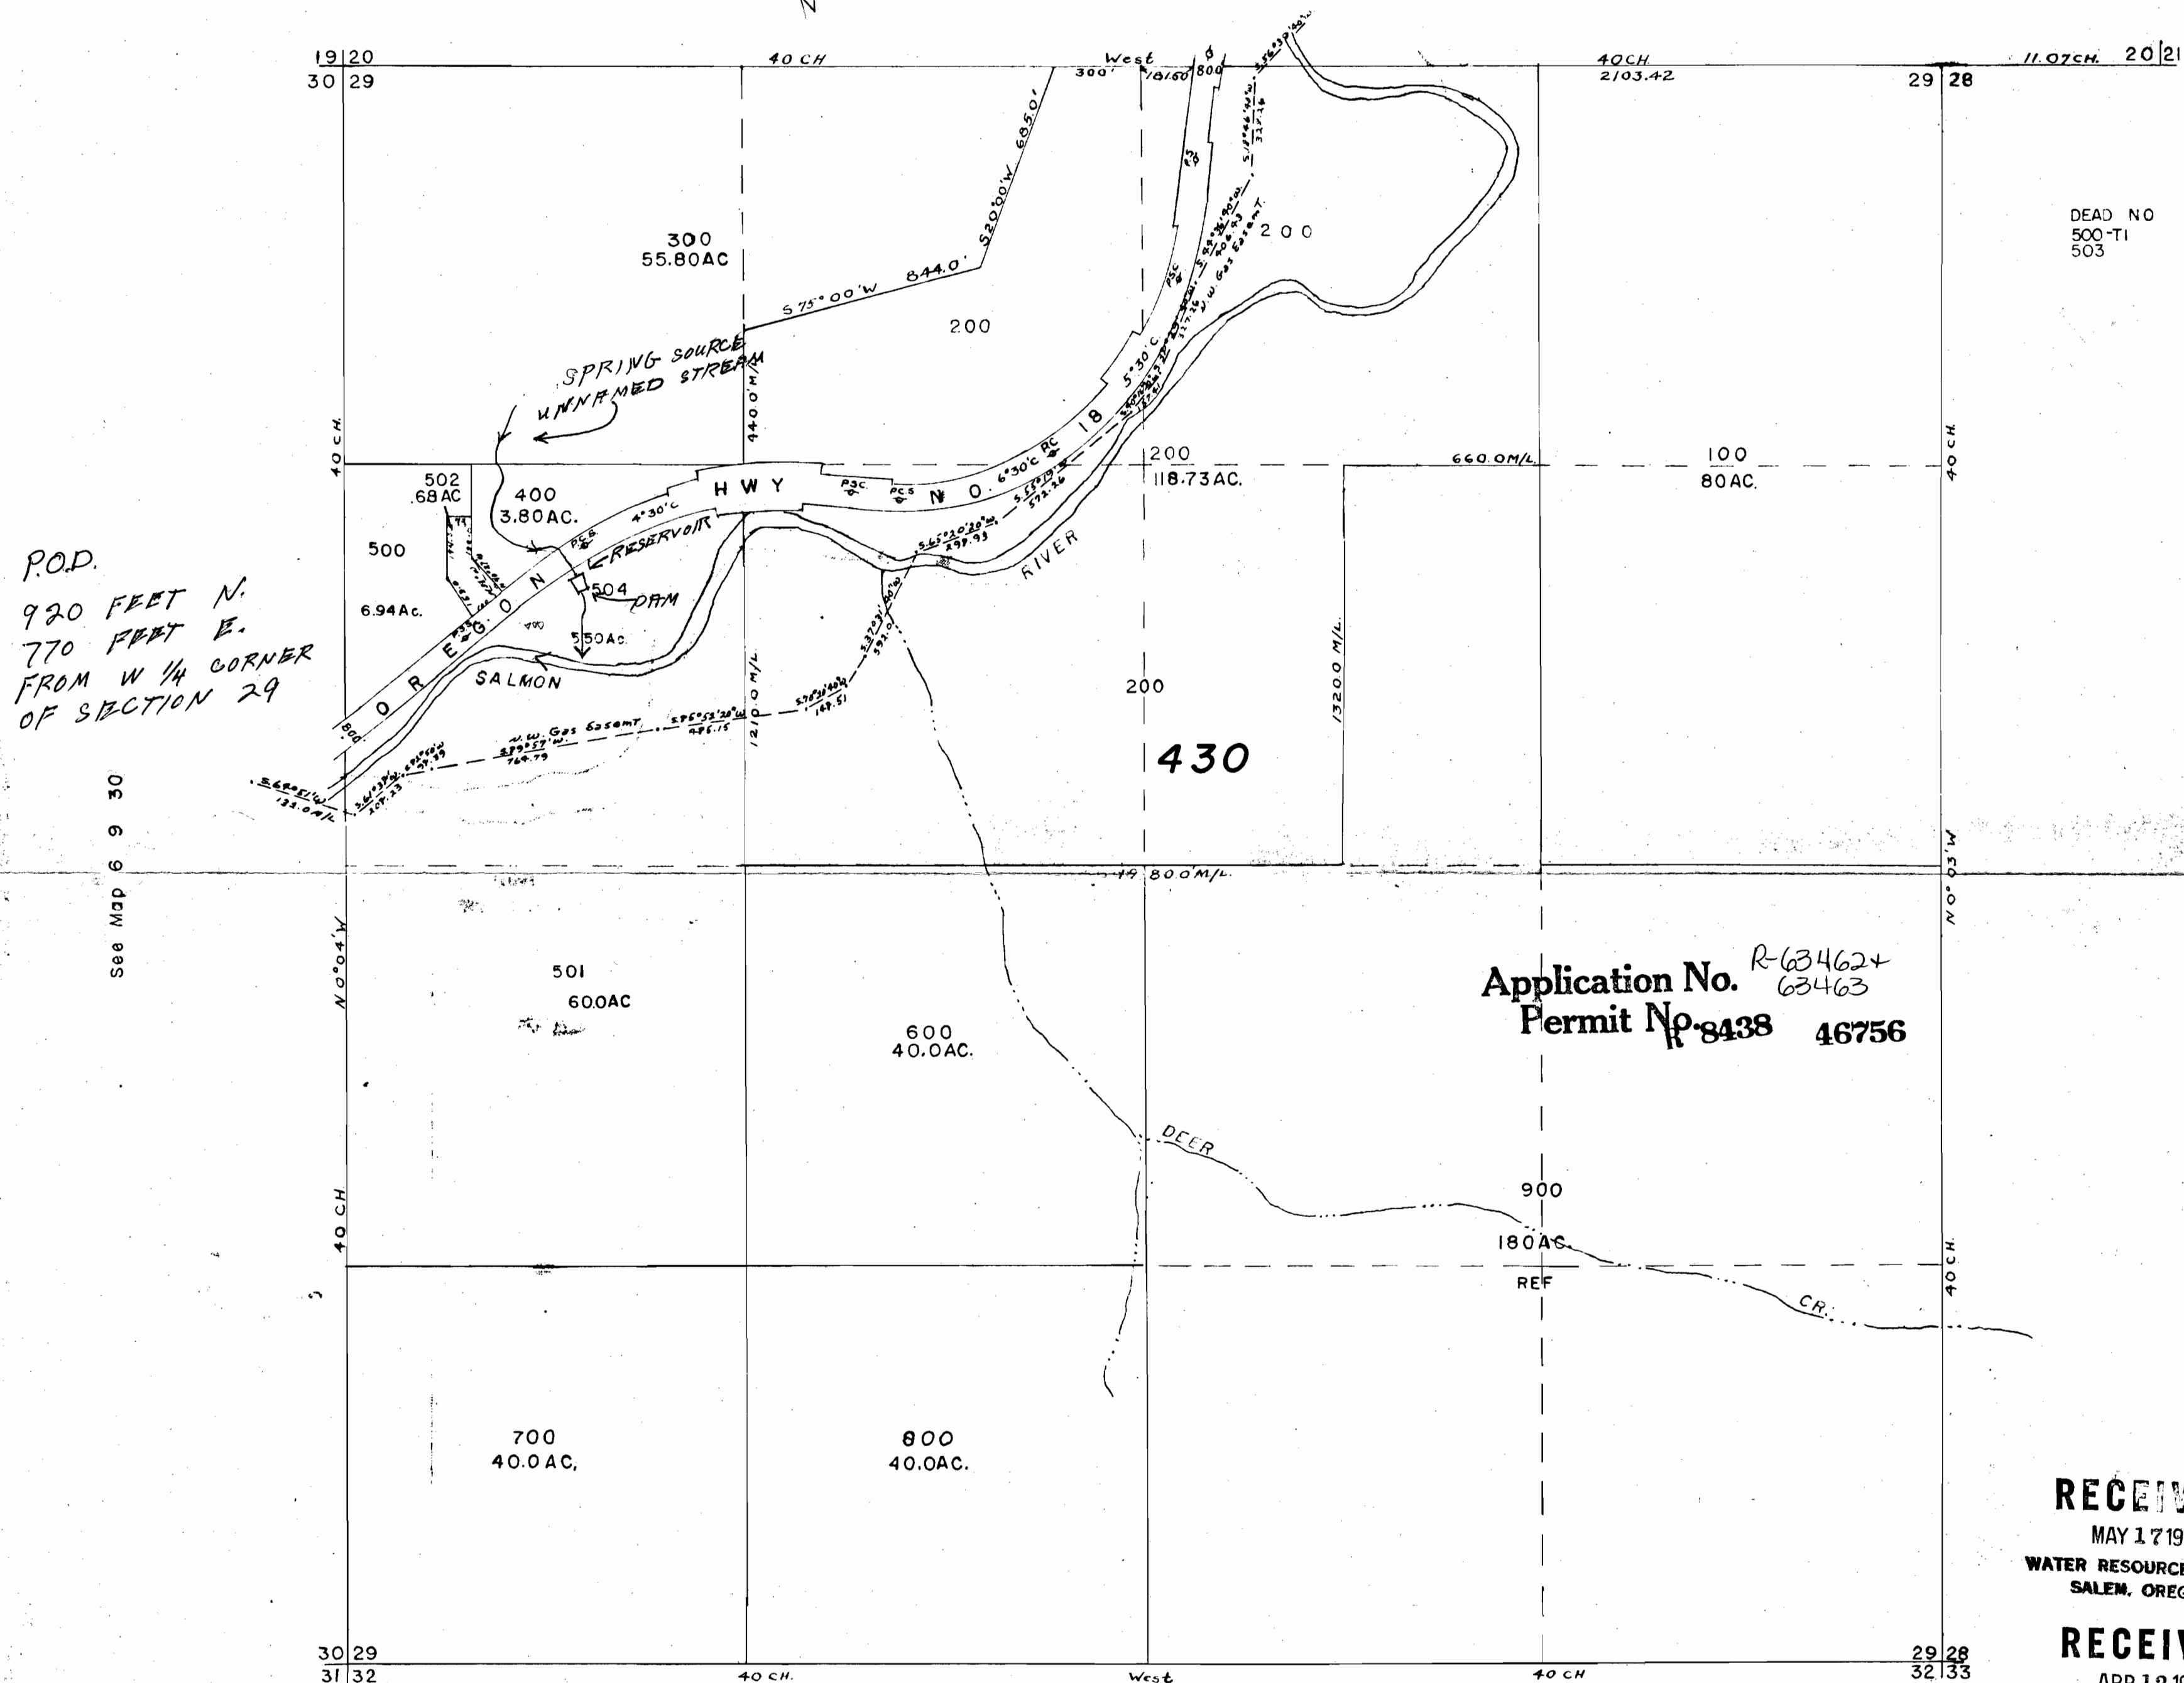

RECEIVED

MAY 17 1982

WATER RESOURCES DEPT
SALEM, OREGON

RECEIVED

APR 12 1982

WATER RESOURCES DEPT
SALEM, OREGON