
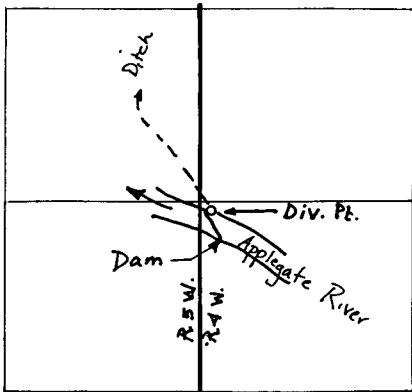


T. 37S., R. 5W., W.M.

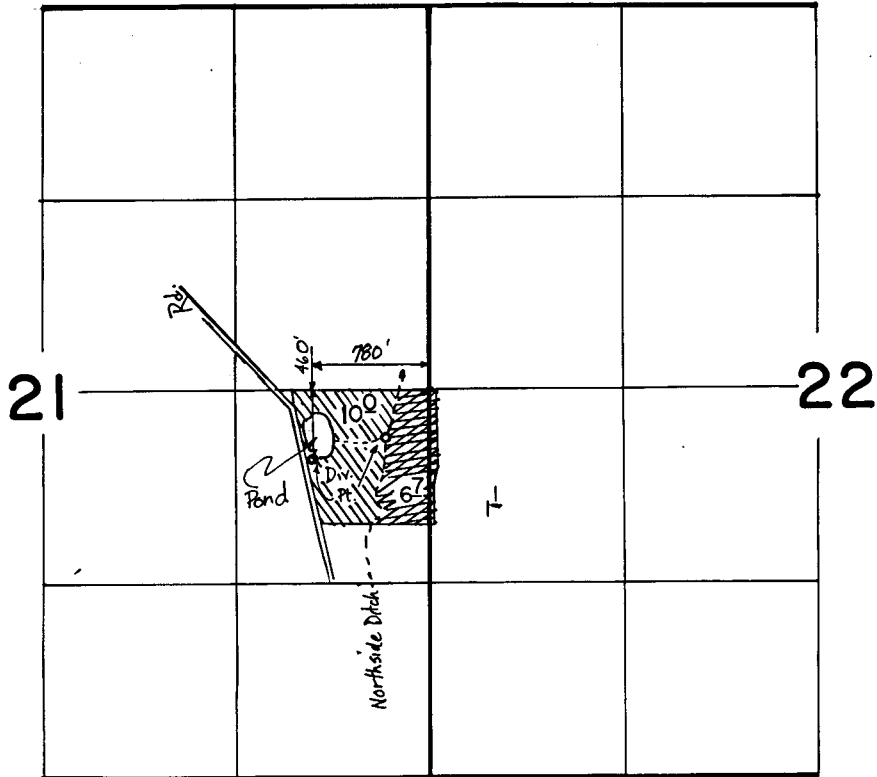

Div. Pt. located 4000' S. &
80' E. from N.W. Cor.
Sec. 6, T. 38S., R. 4W.

Scale: 4" = 1 mile

FINAL PROOF SURVEY
UNDER

63416	46770	
62349	46624	

Application No. G-8896 Permit No. G-8313

IN NAME OF

EDGAR C. & PHYLLIS M. OWEN

Surveyed Mar. 29, 1982, by Bruce R. Sund.
Aug. 18, 1983, B. S. JAMES