

RECEIVED

JAN 5 1981

SECTION PLAT


Section 2

Township 24 S

Range 32 E

WATER RESOURCES DEPT
SALEM, OREGON

County of Harney State of OREGON

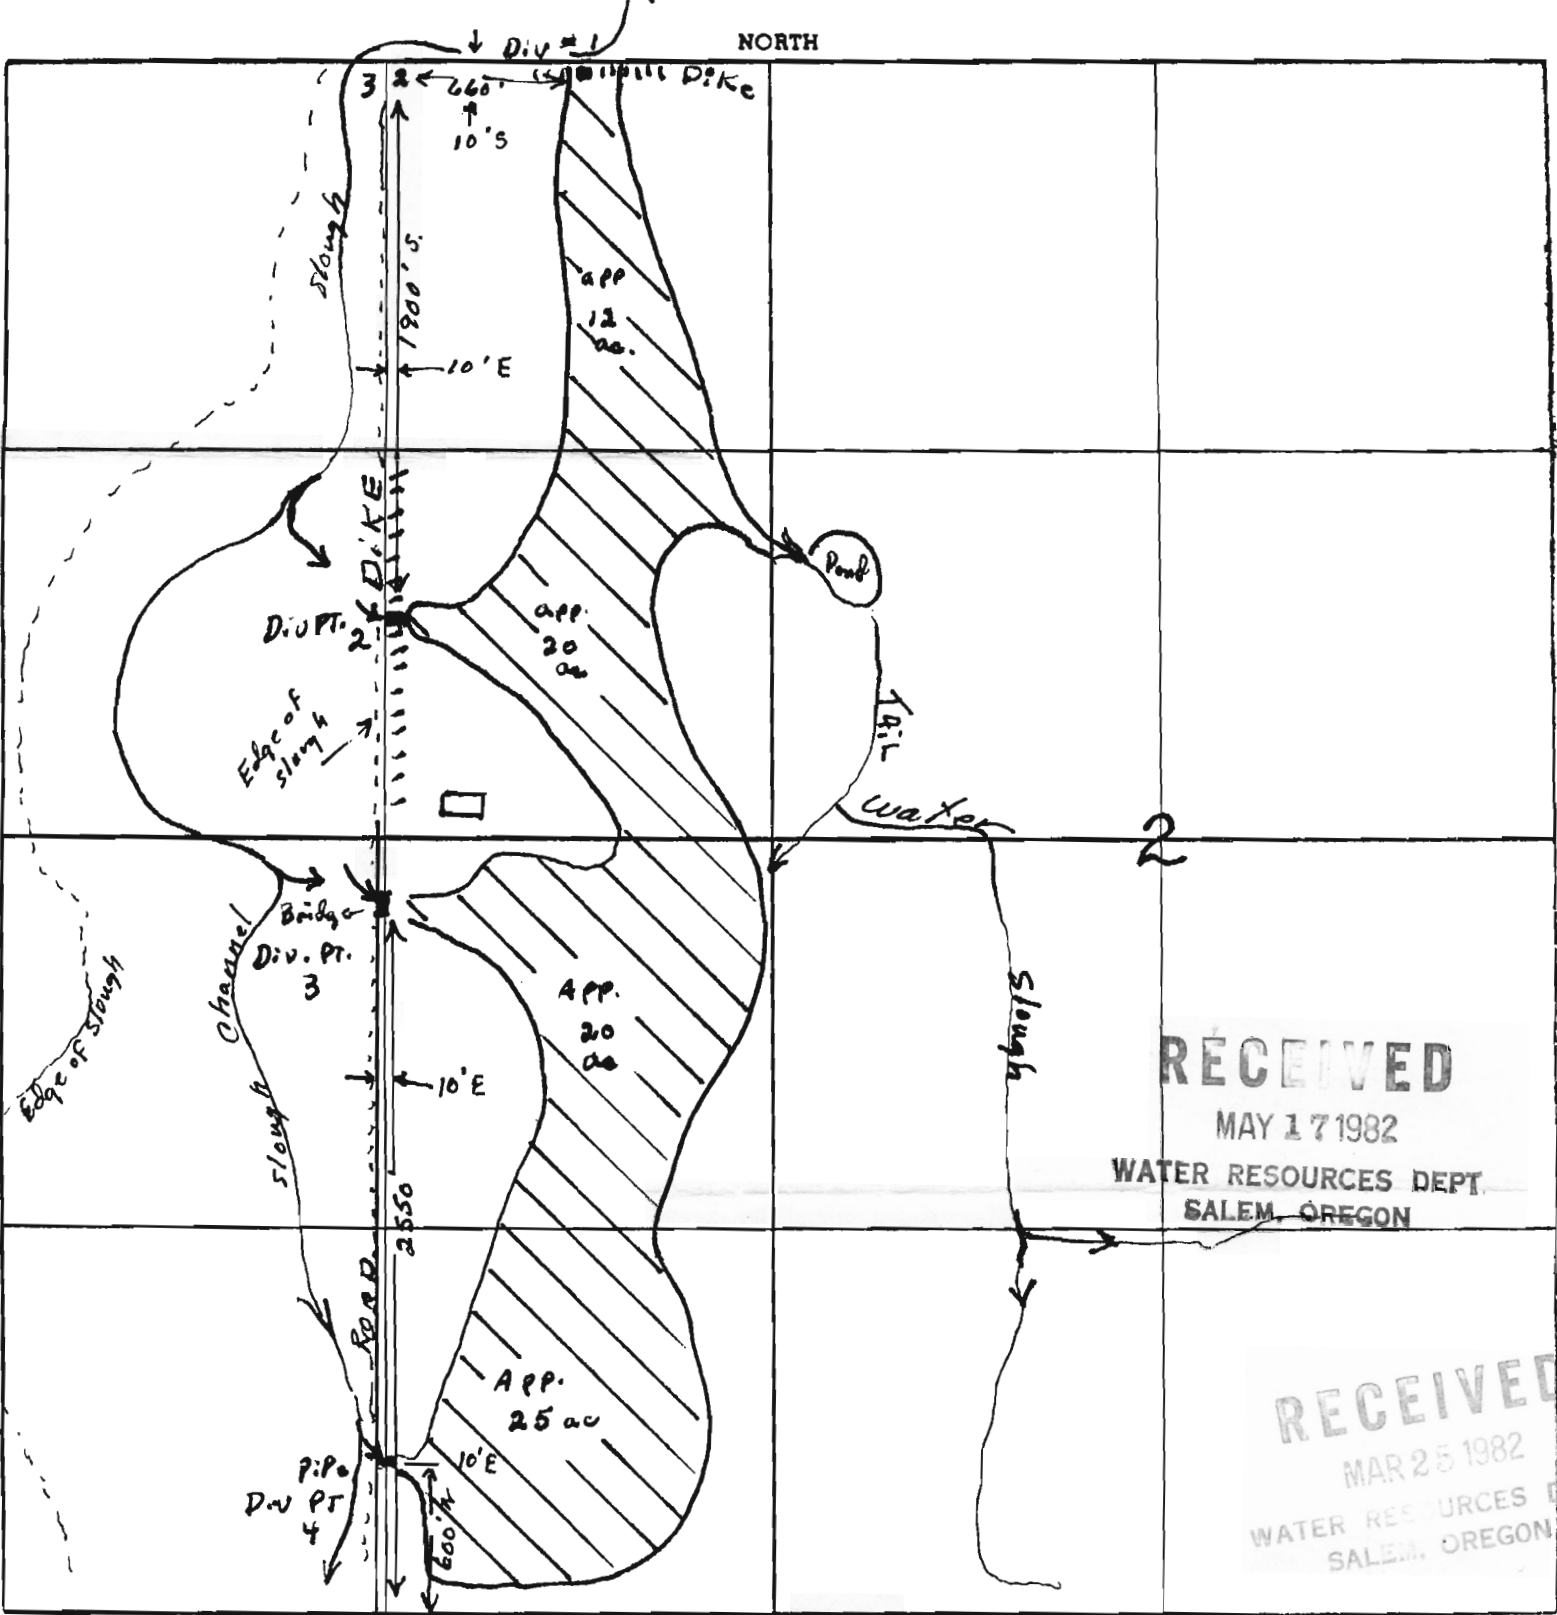

RECEIVED

MAY 17 1982

WATER RESOURCES DEPT
SALEM, OREGON

RECEIVED

MAR 25 1982

WATER RESOURCES DEPT
SALEM, OREGON

Remarks scale - 8" = 1 mile - 660'.

Foley Slough and Poison Crk. are the
Same Source at this Point.

Application No. 6113

Permit No. 46788