SW1/4 SE1/4 SECTION 8 T8S R10W WM

LINCOLN COUNTY

1" = 100'

For Assessors Office Use Only 8 10 8 D C

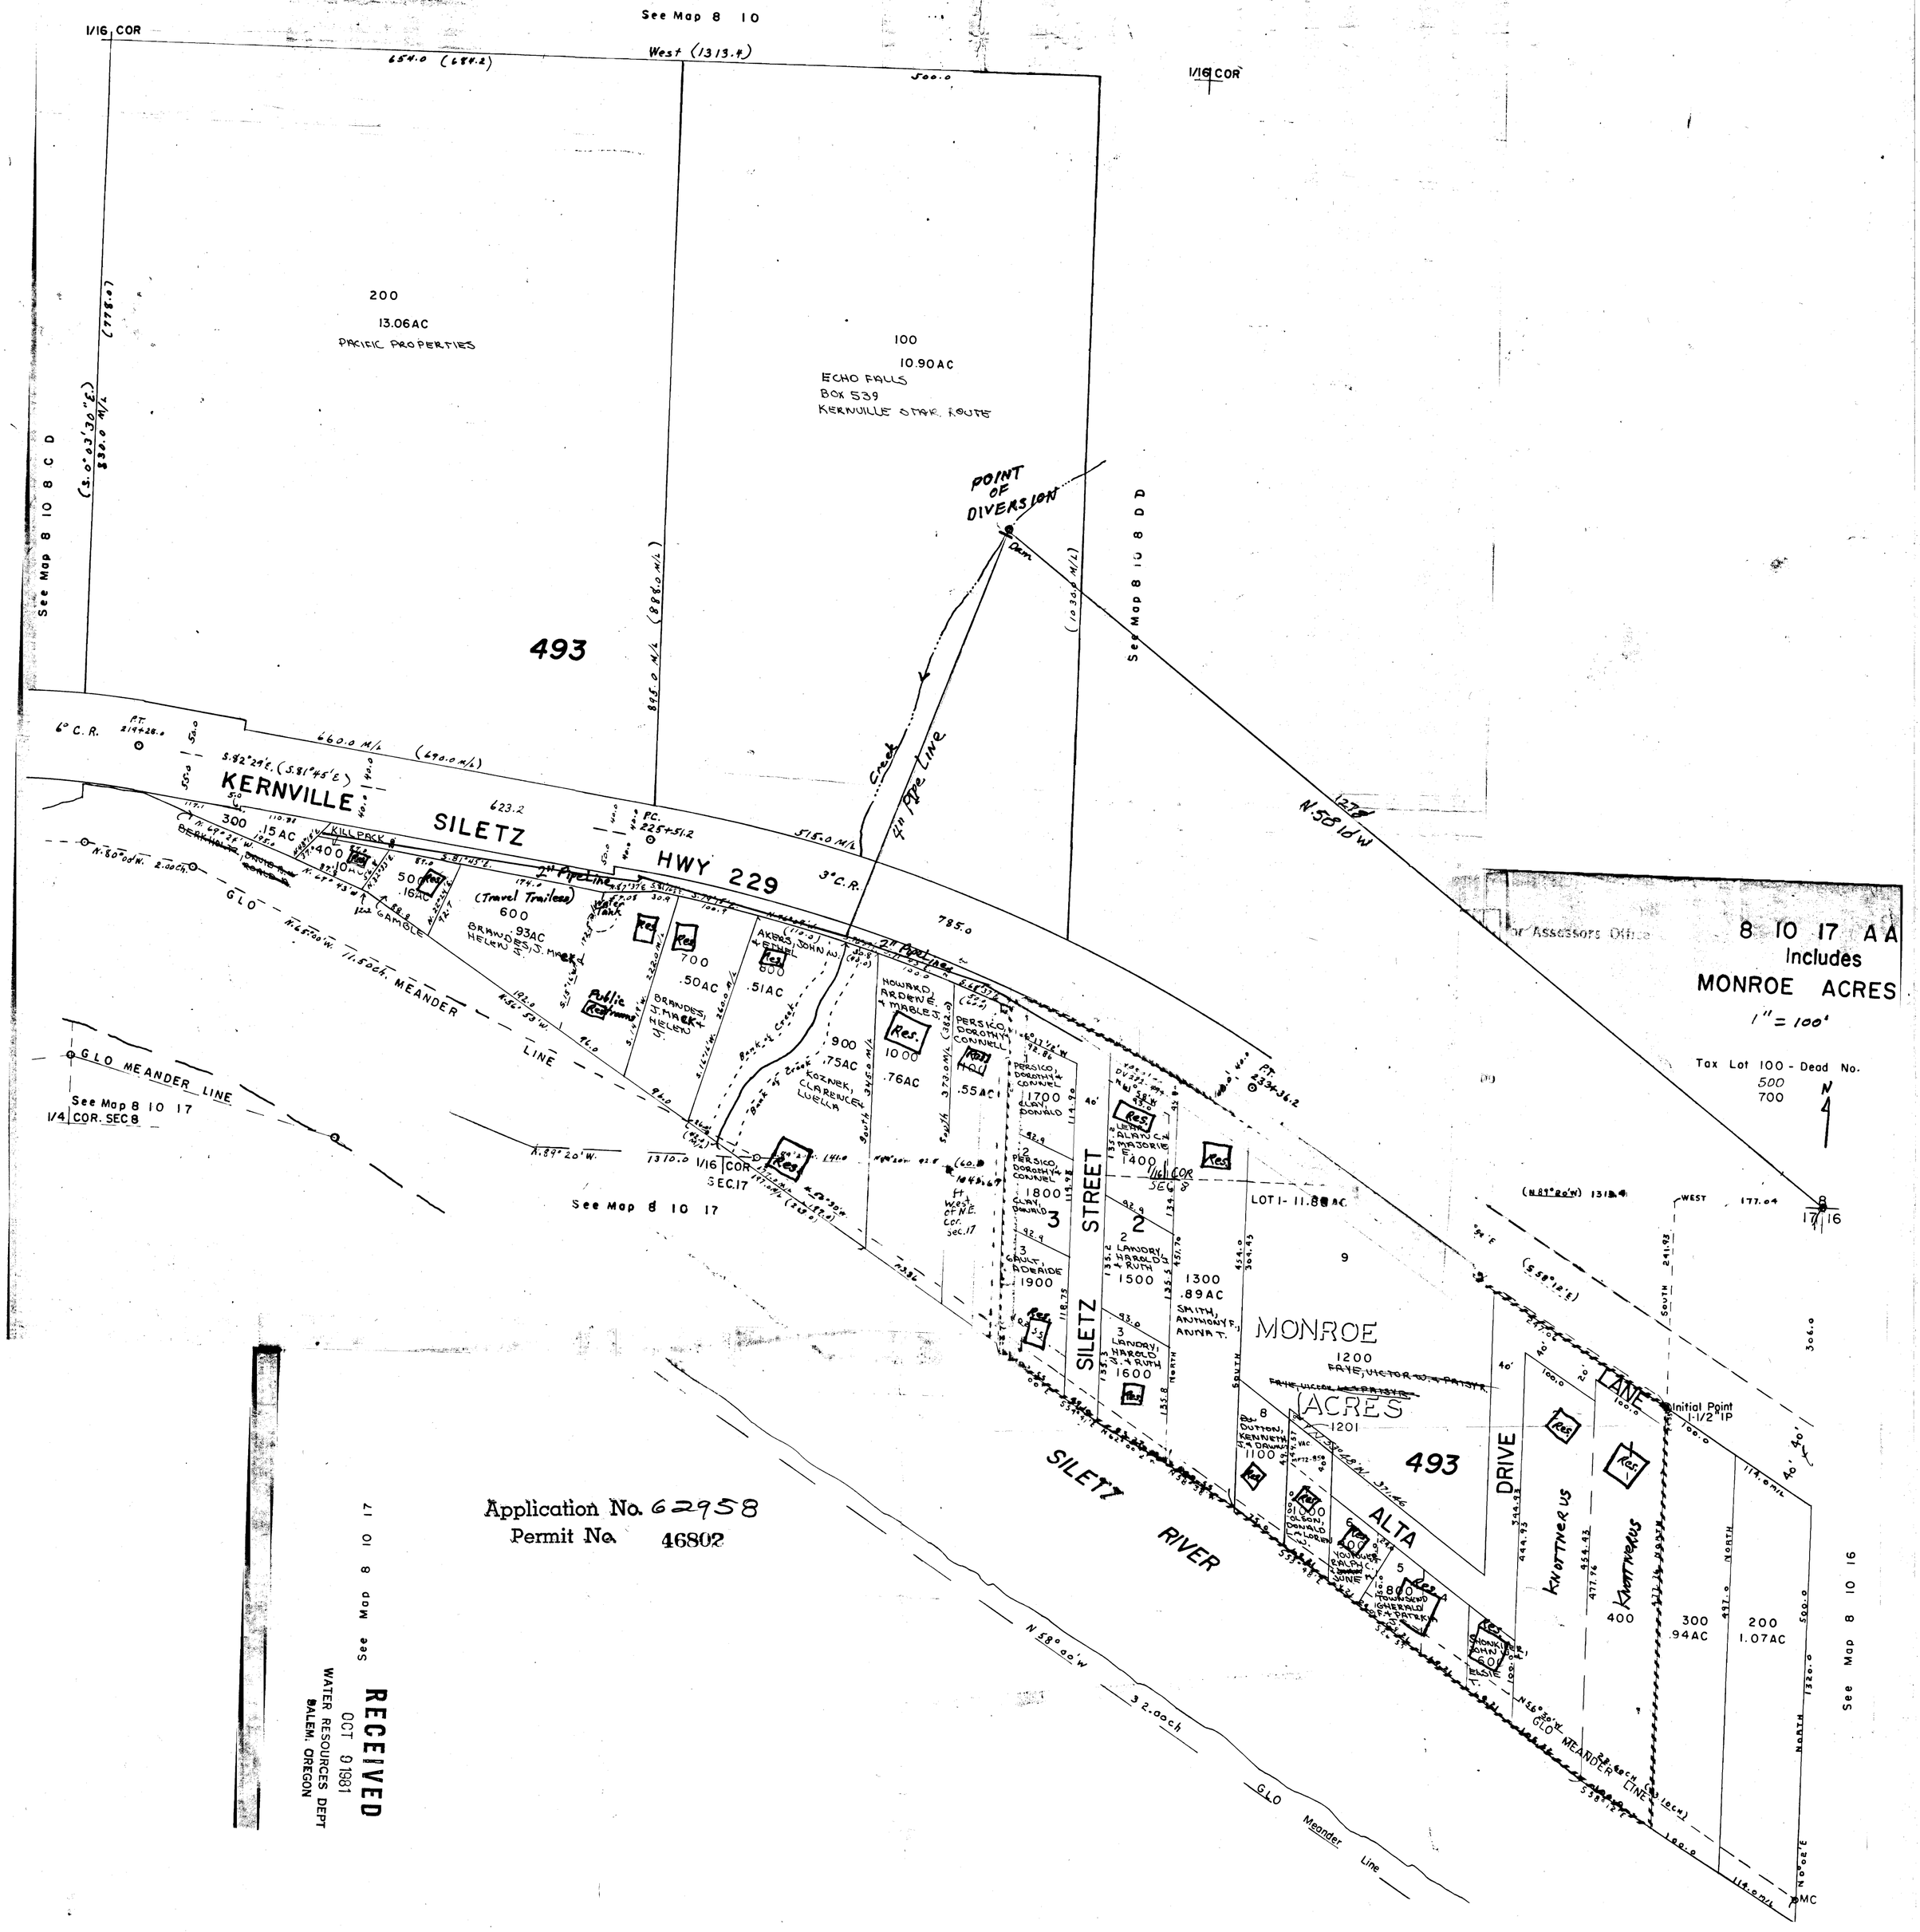

Application No. 62958
Permit No. 46802

RECEIVED
OCT 9 1981
WATER RESOURCES DEPT
SALEM, OREGON