


Township 3 S

Range 2 W

1887

OFFICE OF STATE ENGINEER
RECEIVED
JUN 29 1920
SALEM, OREGON


1887

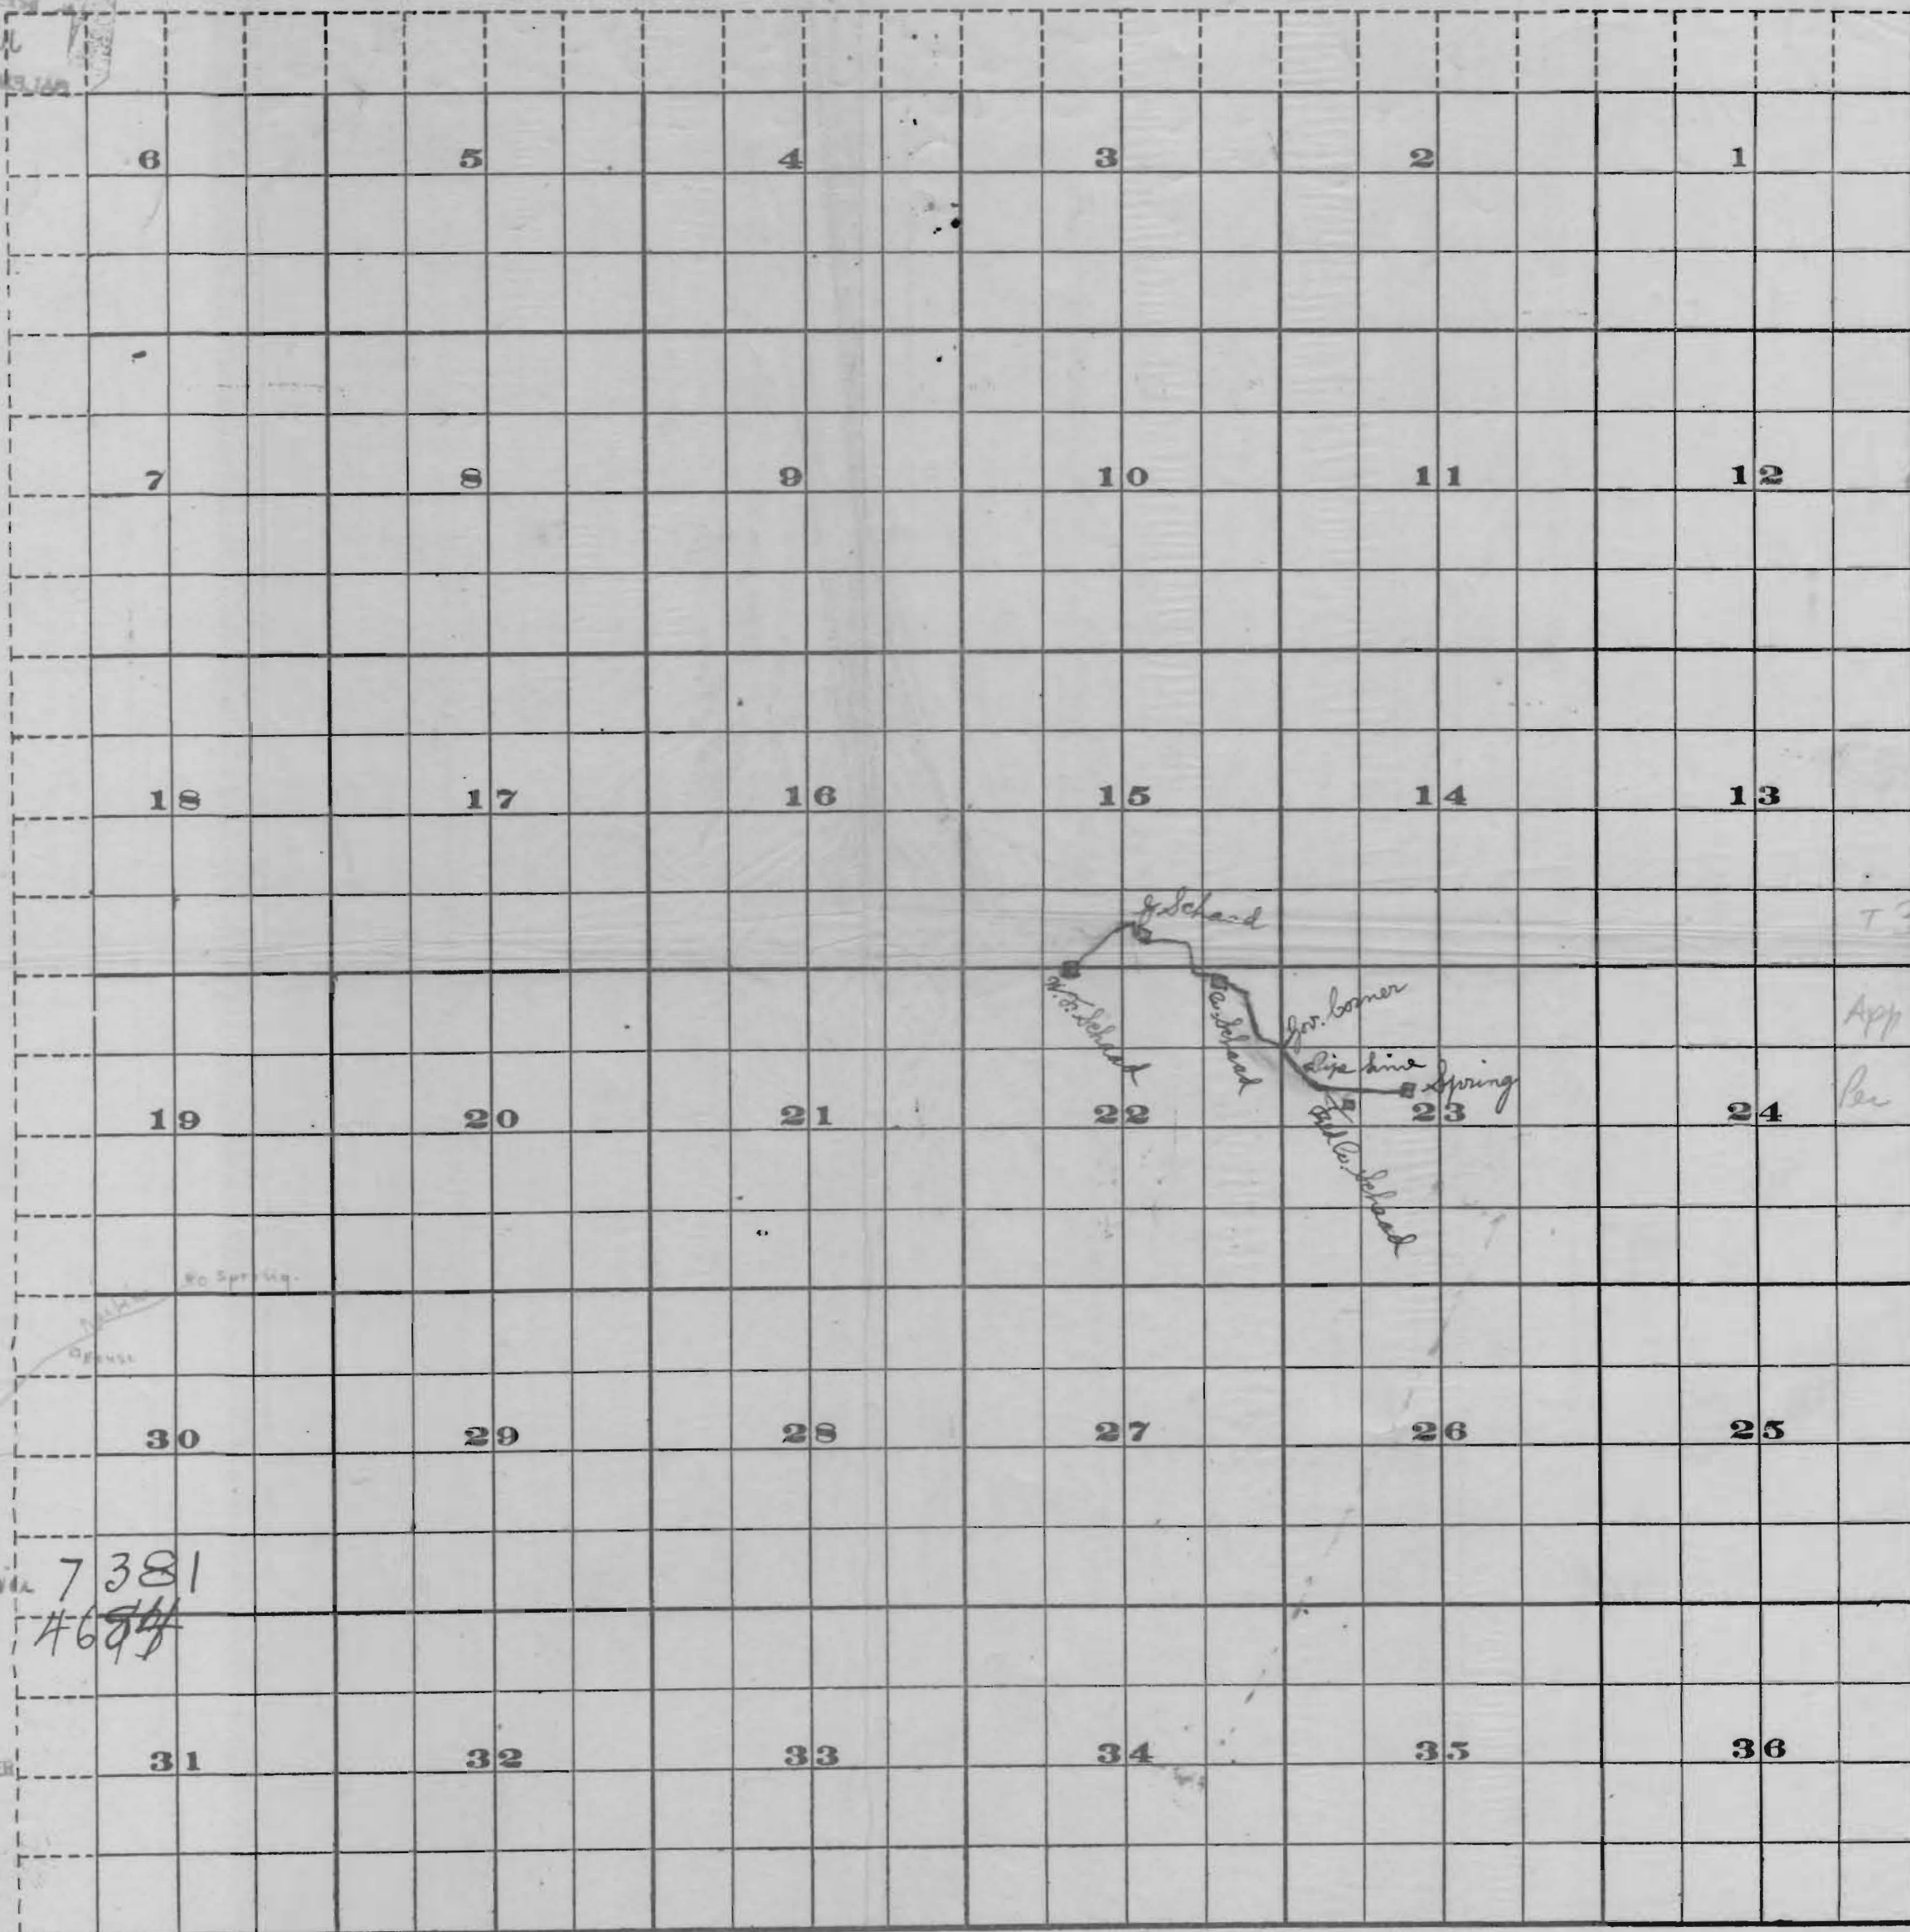

T 3 S R 2
App #7381
Per 4684

Application No. 7381
Permit No. 4684

OFFICE OF STATE ENGINEER
RECEIVED
JUN 29 1920
SALEM, OREGON

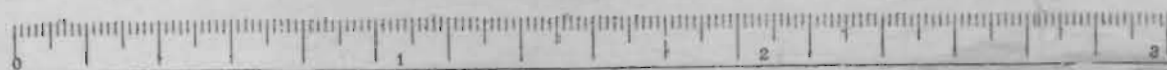

Scale of Feet.

1
3
2
7