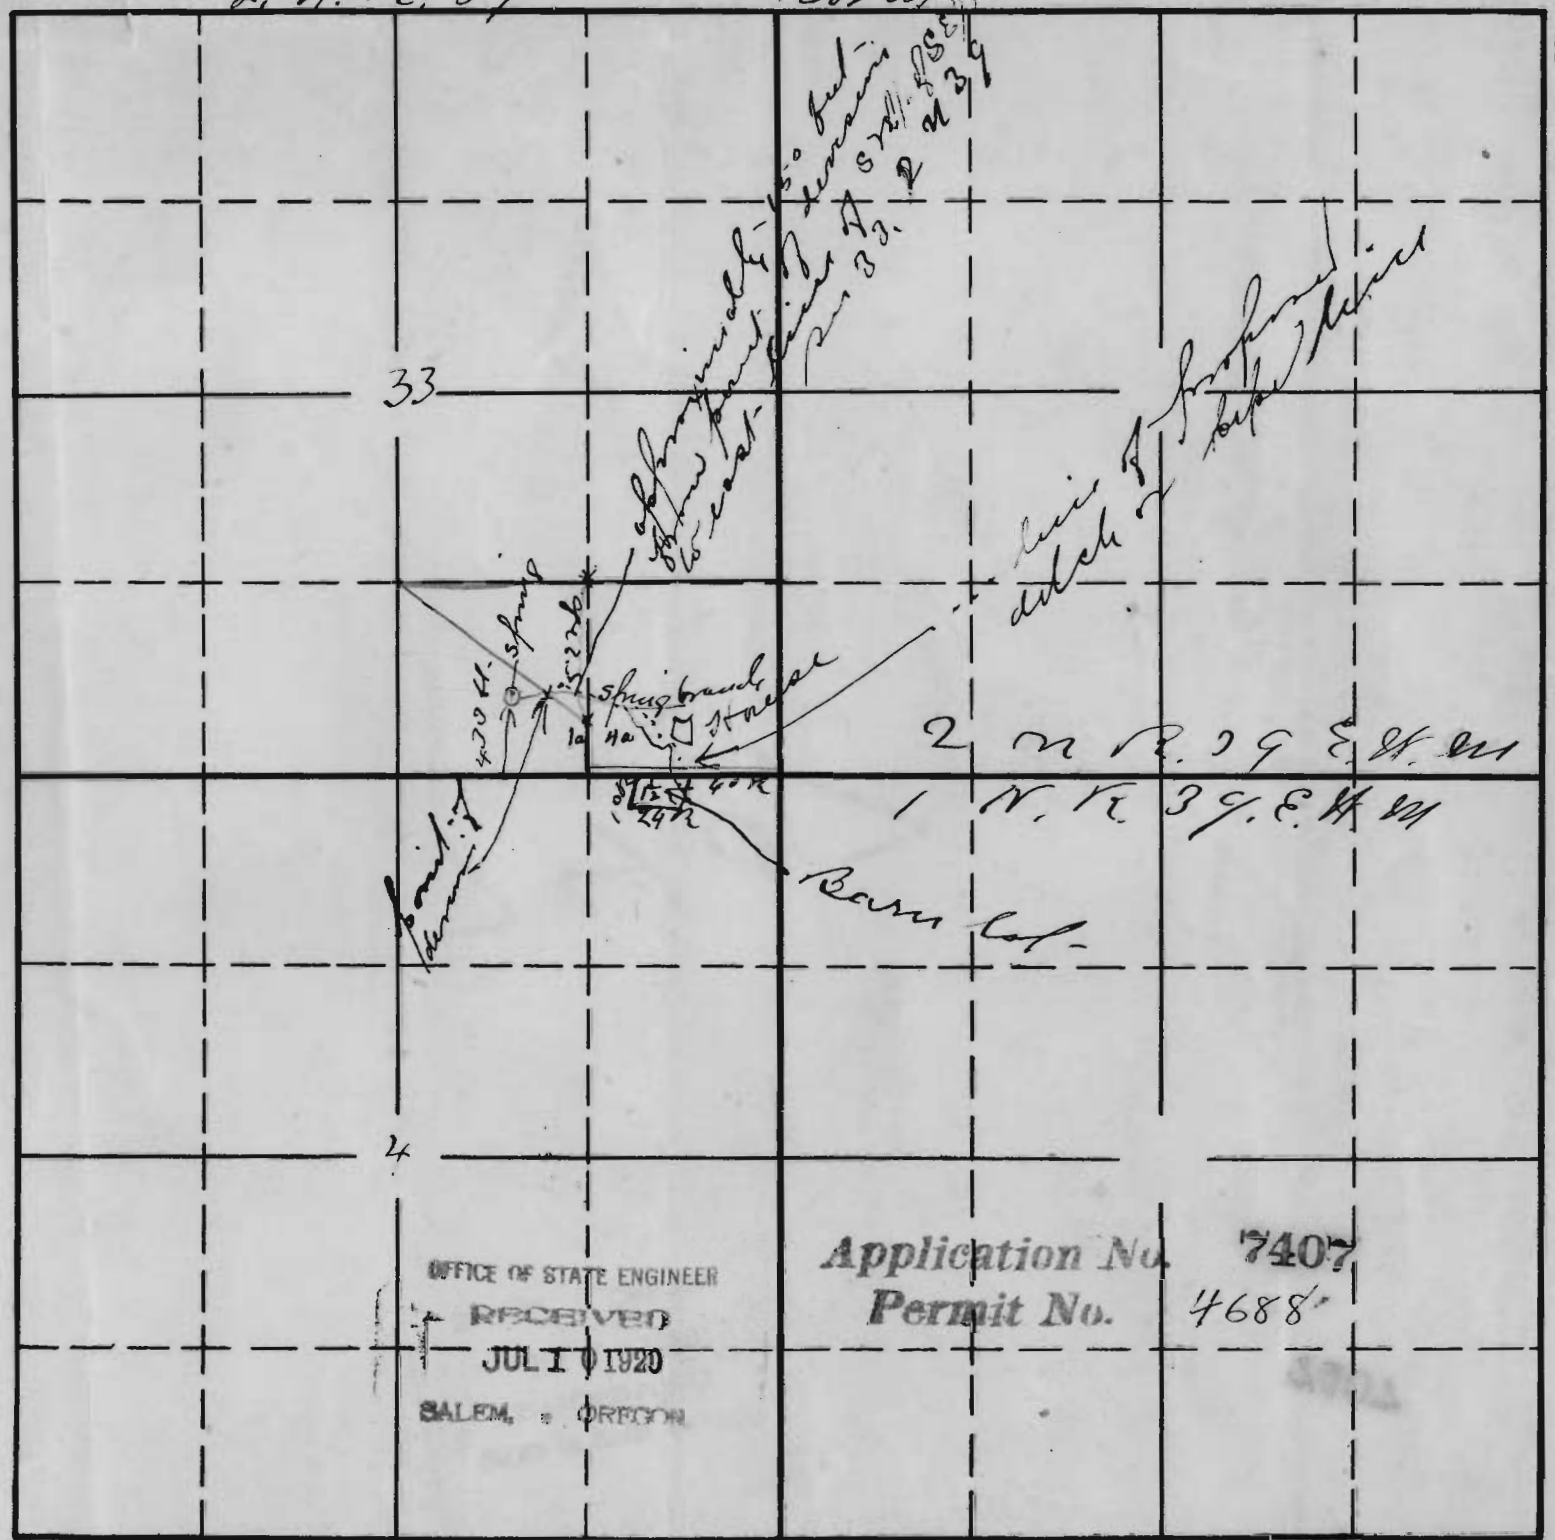
2 N. R. 3 E
Sec.
Tp.
R.
33
4
2 N R. 3 E W.M.
1 N. R. 3 E. W.M.
Barn
OFFICE OF STATE ENGINEER
RECEIVED
JUL 1 0 1920
SALEM, OREGON
Application No. 7407
Permit No. 4688