
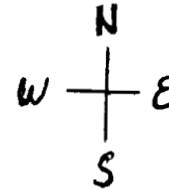


Sec. 32 TWP. 34S
R 2W W.M.

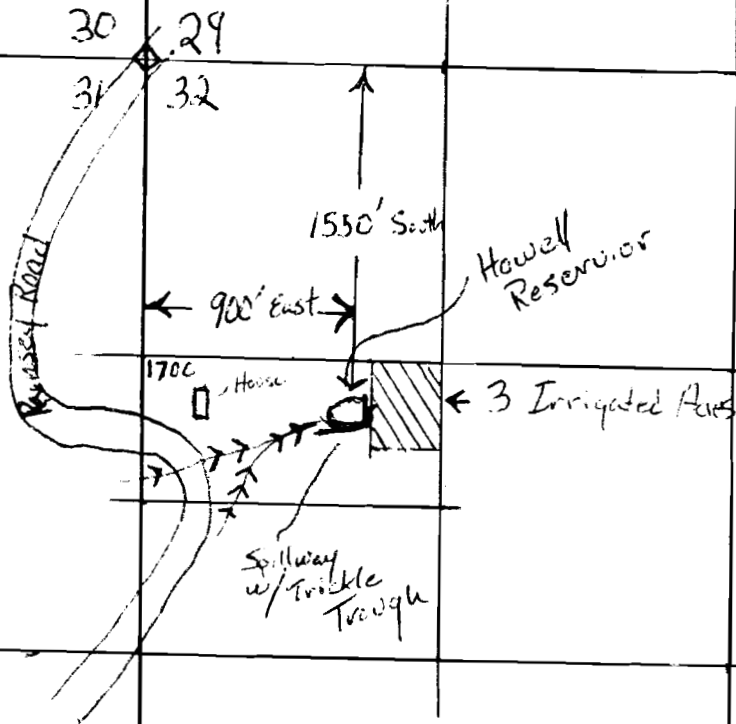

Scale 1" = 800'

Application No. R-62064 & 62065
Permit No. R 8474 46011

RECEIVED
AUG 16 1982
WATER RESOURCES DEPT.
SALEM, OREGON