


T. 37S., R. 6 W., W.M.

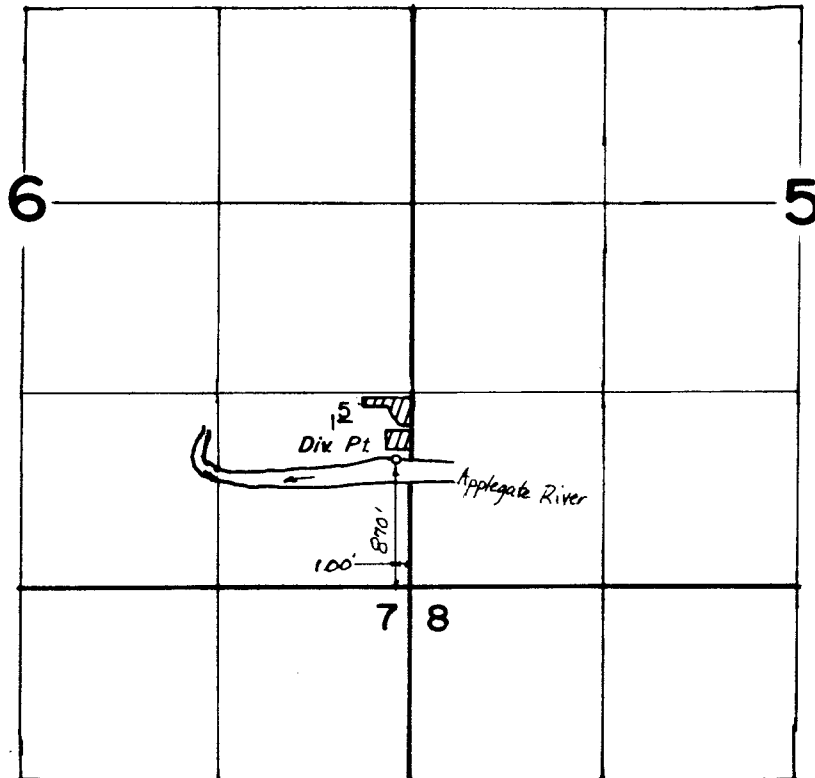

RECORDED

AUG 09 1989

WILLIAMS &
MORRIS ENGINEERS

FINAL PROOF SURVEY
UNDER

Application No. .52250.. Permit No. .46944.....
IN NAME OF

.....**TOM & PAULA PATTEE**.....

Surveyed .OCT. 18, . 1983., by .B...S...JAMES.....