


T. 37 S., R. 6 W., W. M.

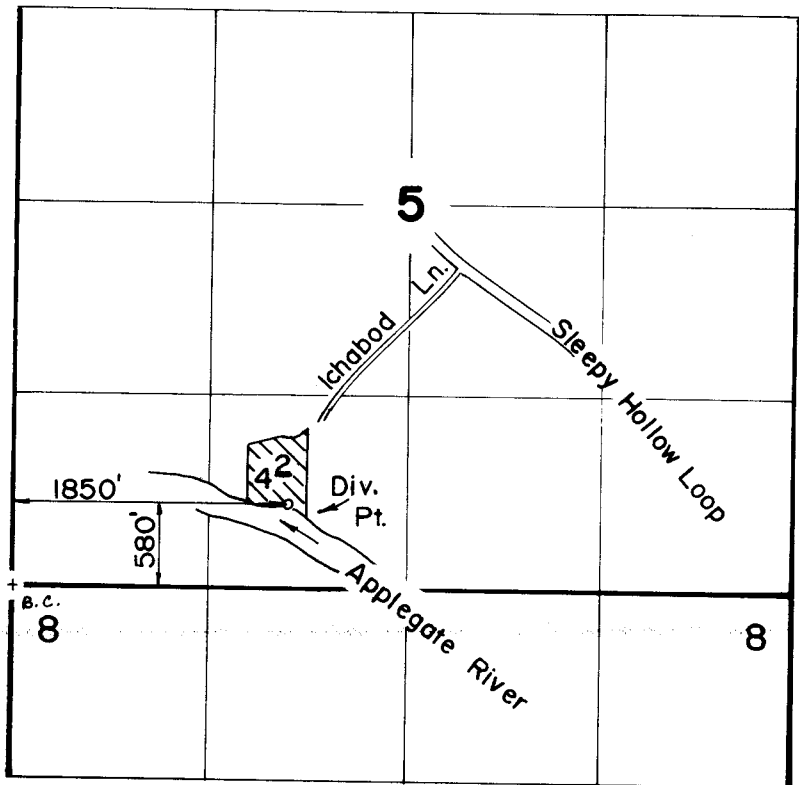

Scale: 1" = 1320'

RECEIVED

NOV 16 1990

DIST. 14  

**FINAL PROOF SURVEY**  
UNDER

Application No. 62533 Permit No. 46947  
IN NAME OF

ROBERT J. MILLER

Surveyed AUG. 14, 1986, by B. S. JAMES

B.50-3-11 (M.)