

RECEIVED

AUG 23 1982

WATER RESOURCES DEPT.  
SALEM, OREGON

BOB CHRISTIANSEN  
Route 1, Box 905  
Bandon, OR 97411


RECEIVED

JUL 19 1982

WATER RESOURCES DEPT.  
SALEM, OREGON

T29S R14W

Application No. G-10765, R-63722 & 63723  
Permit No. G 9860 R 8483 46952

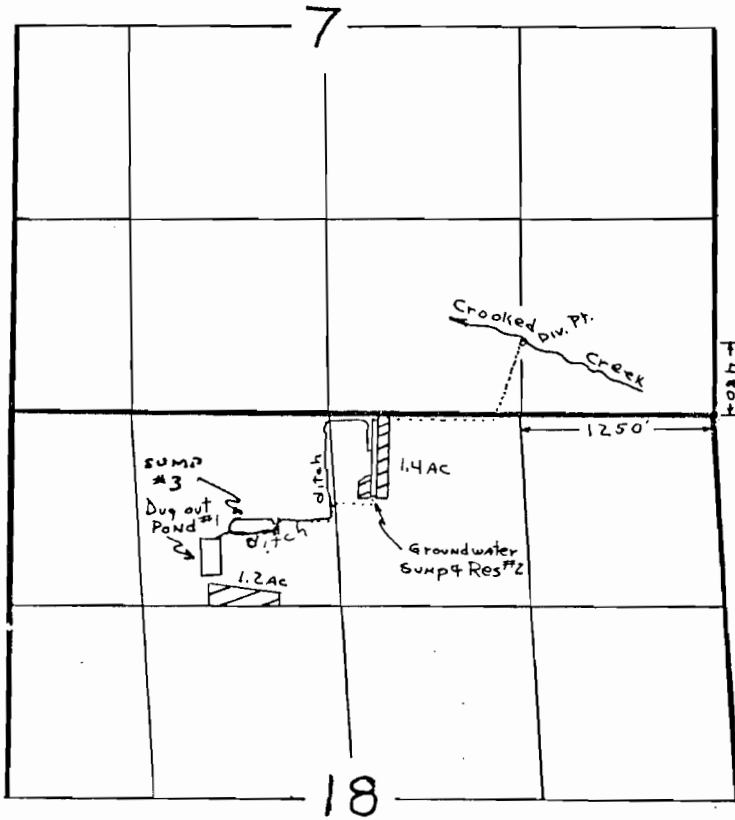

P.O.D.'s

Crooked Cr	480' N	1250' W	} from NE cor Sec 18
Dug out pond #1	1120' S	3440' W	
Sump/Res #2	600' S	2300' W	

THIS MAP PREPARED BY: J.P. Drolet, Coquille Field Office  
FROM INFORMATION FURNISHED BY THE  
APPLICANT.