


# T. 39 S., R. 5 W., W. M.

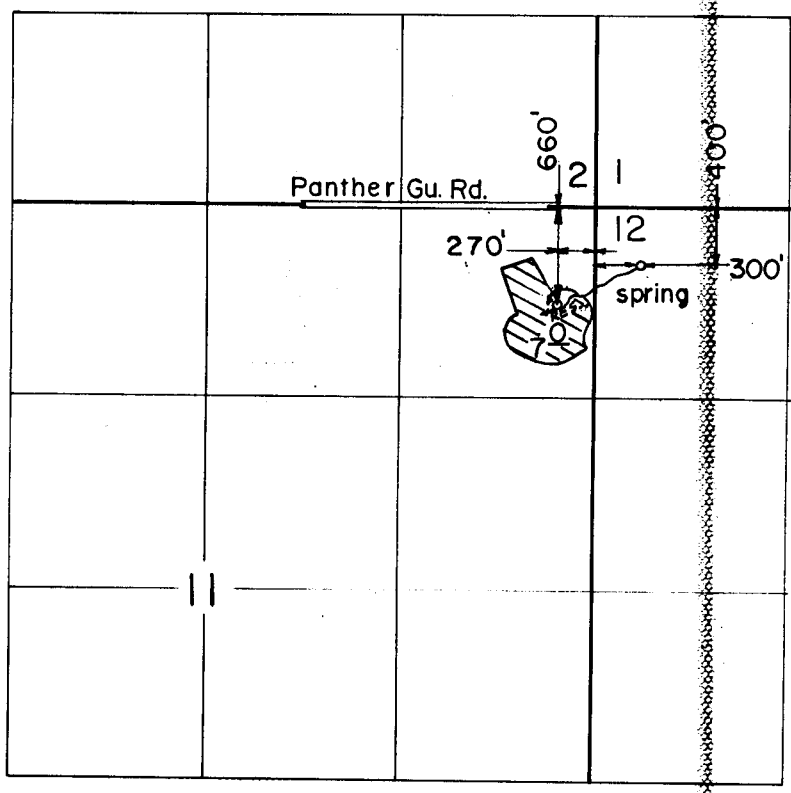

Scale: 1" = 1320'

RECEIVED  
 MAY 20 1991  
 WM. DIST. 14  
 GRANTS PASS, ORE.

## FINAL PROOF SURVEY UNDER

R-61411                      R-8490

Application No. 61412..... Permit No. 46968.....  
 IN NAME OF

.....JOSEPH B. FICHTNER.....

Surveyed JUL...6... 1988, by B...S...JAMES..