


OW Decker,  
Richland Oregon  
Applicant

July 13-1920

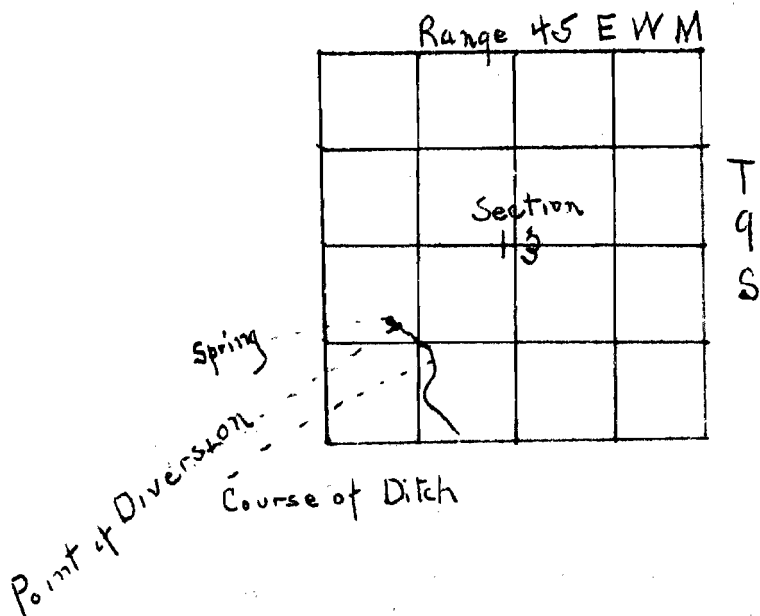

OFFICE OF STATE ENGINEER  
RECEIVED  
JUL 16 1920  
SALEM, OREGON

Application No.  
Permit No.

7422  
4698